

INSPECTION REPORT

15-009-22358-00-00  
15-009-22346-00-00

Case# \_\_\_\_\_

|                                     |                     |
|-------------------------------------|---------------------|
| <input type="checkbox"/>            | Complaint           |
| <input checked="" type="checkbox"/> | New Situation       |
| <input type="checkbox"/>            | Response to request |
| <input type="checkbox"/>            | Follow-up           |

Date of Inspection: January 11, 2016

Operator: RJM Company

License: 30458

Address: PO BOX 256

Location: SE/4 7-16-11W

City/St: Clafin, KS 67525

Lease: Staudinger

Phone: (620) 588-3910

County: Barton

Reason for investigation: Periodic Lease inspection

Problem: Producing well with wrong Well number and API number

**Findings:**

- Lease inspection done on January 11, 2016 the following was found. Wells on this lease were bought from another company using the records from this company for well names and numbers.
- The Staudinger # 2 API 15-009-22346-00-00 Spot location S2 SE SW. This well is on RJM's inventory as a producing well.
- Checking records in the Hays office it was found that 2 wells were drilled close to the same spot location. The Staudinger #V-2 API 15-009-07186-00-00 was drilled 70' west of the well that is producing. This well was drilled in 1943 and plugged in 1951 with a plugging report on file in the office.
- Staudinger # 3 API 15-009-22358-00-00 GPS location Lat. 38.66758 Long. -098.57748. Spot location SE SW SE. This well was drilled and completed in 1981 and is the well that was producing at time of inspection.
- The Stauding #2 API 15-009-22346-00-00 Spot location C S2 SE SW. Was drilled in 1981 as a Dry hole and plugged with a plugging report on file in the office.
- RJM will correct the well inventory on record with Kolar. Changing the producing well to the Staudinger #3 API 15-009-22358-00-00. GPS location Lat. 38.66758 Long. 98.57748 Spot location SE SW SE..

Photos: No

Bruce Rodie E.C.R.S.  
(agent)

Bruce Rodie  
(signature)

cc: file

Conservation Division  
District Office No. 4  
2301 E. 13th Street  
Hays, KS 67601-2651



Phone: 785-625-0550  
Fax: 785-625-0564  
<http://kcc.ks.gov/>

Jay Scott Emler, Chairman  
Shari Feist Albrecht, Commissioner  
Pat Apple, Commissioner

Sam Brownback, Governor

MEMO

To:

From: Bruce Rodie, KCC Hays office

Regarding: RJM well inventory SE/4 7-16-11W

Date: January 25, 2016


The well Inventory for RJM CO. License 30458 Shows the Staudinger #2 API 15-009-22346 as a producing well. Two wells were drilled close the same spot location and RJM used the records for the wells from the company they bought the wells from. The Staudinger #2 was drilled in the SW/4 not the SE/4 and was DRY HOLE. The well drilled next to the producing well was the Staudinger V-2 and was plugged in 1951. The producing well is the Staudinger #3 and was drilled and completed in 1981.

RBDMS needs to be changed the show the Staudinger #2 API 15-009-22346-00 as a Plugged well. Copy of plugging report is attached.

The Staudinger #3 API 15-009-22358-00-00 needs to be changed to a producing well.

Section

7-16-11W

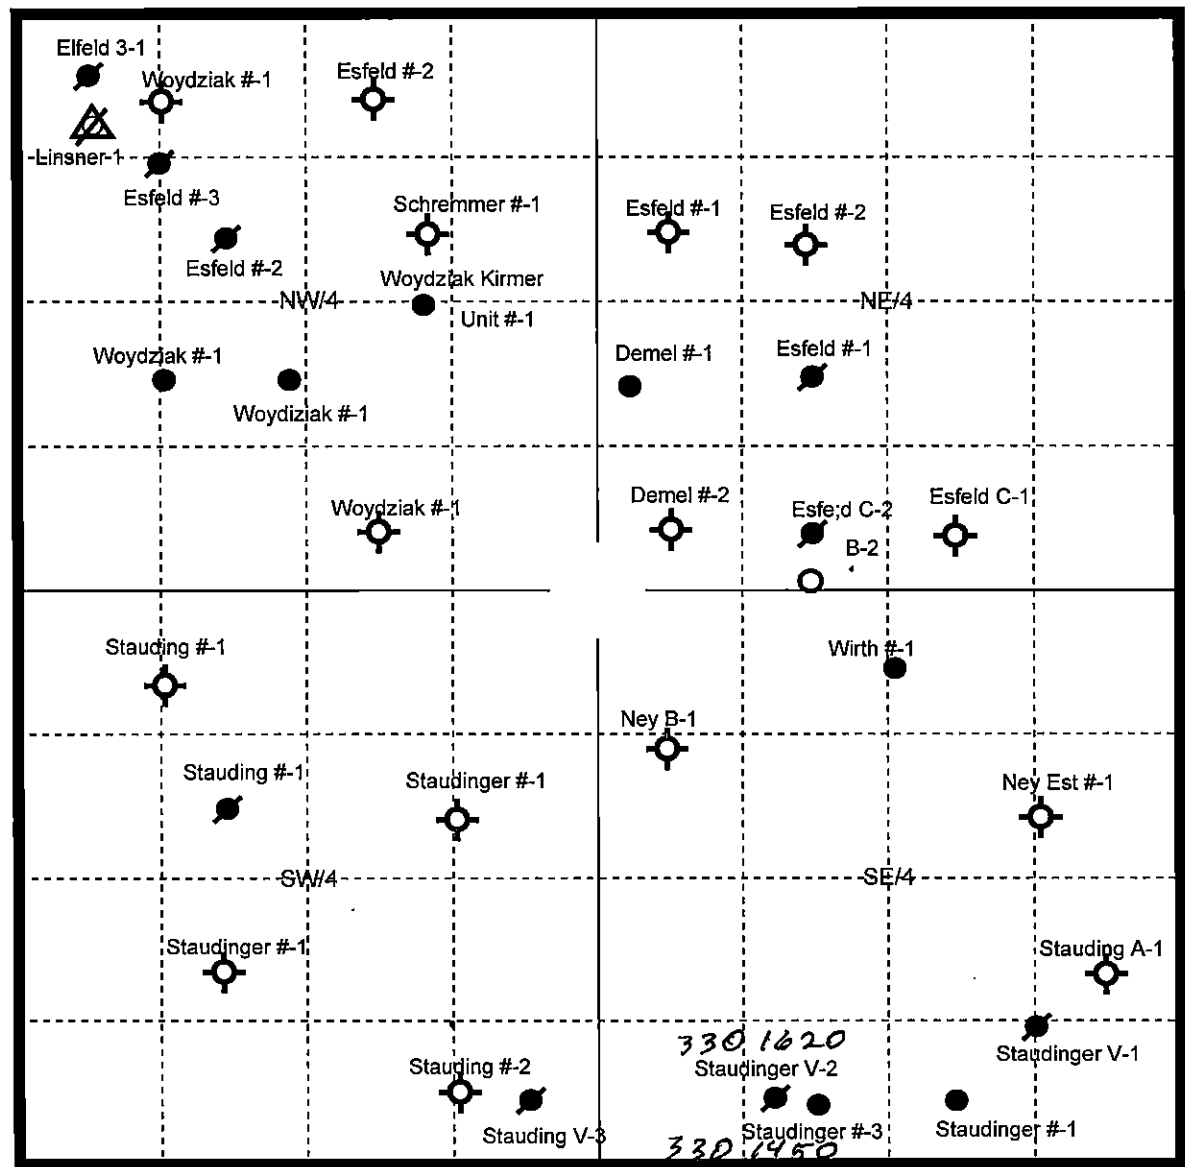

5280  
4950  
4620  
4260  
3960  
3630  
3300  
2970  
2640  
2310  
1980  
1650  
1320  
990  
660  
330

5280 4950 4620 4260 3960 3630 3300 2970 2640 2310 1980 1650 1320 990 660 330

- Plugged SWD
- SWD
- Dry Hole
- Temporary Abandoned
- Water Supply Well
- Plugged Injection Well
- Oil Well
- Abandoned
- Gas Well
- Plugged Well
- Tank Battery
- Injection Well
- Plugged Gas Well
- Pit
- Plugged Water Supply Well

Bruce Rodie

KCC Agent