


WELL PLUGGING RECORD

Give All Information Completely
Make Required Affidavit
Mail or Deliver Report to:
Conservation Division
State Corporation Commission
800 Bittling Building
Wichita, Kansas

Barton County. Sec. 15 Twp. 16 Rge. 11 (E) (W)
Location as "NE/CNW $\frac{1}{4}$ SW $\frac{1}{4}$ " or footage from lines NW SE NW
Lease Owner B & R Drilling, Inc.
Lease Name Esfeld Well No. 1
Office Address Drawer 232, Russell, Ks.
Character of Well (completed as Oil, Gas or Dry Hole) Dry Hole
Date well completed 10/22 19 51
Application for plugging filed 10/22 Verbal 19 51
Application for plugging approved 10/22 Verbal 19 51
Plugging commenced 10/22 19 51
Plugging completed 10/23 19 51
Reason for abandonment of well or producing formation Dry Hole

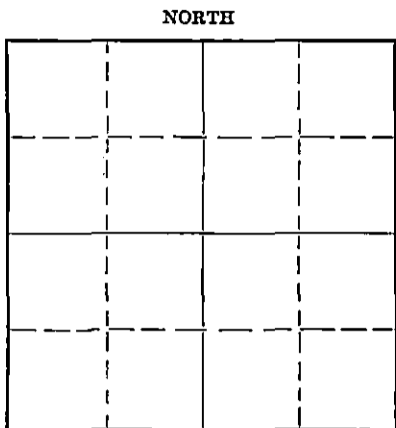

Locate well correctly on above Section Plat

If a producing well is abandoned, date of last production 19.....
Was permission obtained from the Conservation Division or its agents before plugging was commenced? Yes

Name of Conservation Agent who supervised plugging of this well.....
Producing formation..... Depth to top..... Bottom..... Total Depth of Well 3436 Feet
Show depth and thickness of all water, oil and gas formations.

OIL, GAS OR WATER RECORDS

CASING RECORD

Formation	Content	From	To	Size	Put In	Pulled Out
				8 5/8"	250'	None

Describe in detail the manner in which the well was plugged, indicating where the mud fluid was placed and the method or methods used in introducing it into the hole. If cement or other plugs were used, state the character of same and depth placed, from.....feet to.....feet for each plug set.

Filled hole with heavy mud to 250'. Wood plug and 15 sacks cement mixed and poured through drill pipe. Filled hole to 35'. Wooden plug and 10 sacks cement.

RECORDED
STATE COPY
NOV - 1 - 1951
CONSERVATION DIVISION
Wichita, Kansas

(If additional description is necessary, use BACK of this sheet)

Correspondence regarding this well should be addressed to B & R Drilling, Inc.
Address Drawer 232
Russell, Ks.

STATE OF KANSAS, COUNTY OF RUSSELL, ss.
W. A. Michaelis (employee of owner) or (owner or operator) of the above-described well,
being first duly sworn on oath, says: That I have knowledge of the facts, statements, and matters herein contained and the log of the above-described well as filed and that the same are true and correct. So help me God.

(Signature) *W. A. Michaelis*
Russell, Ks.

(Address)

SUBSCRIBED AND SWORN TO before me this 31st day of October, 1951

Blair Hummel

Notary Public.

My commission expires 6/17/54

PLUGGING
FILE SEC 15 T 16 R 11 W
BOOK PAGE 119 LINE 12

B & R Drilling, Inc.
Barton County, Kansas
Esfeld No. 2

15-09-06-24-0000
NW-SE-NW-15-16-11

Total Depth: 3436'
Comm: 10-8-51
Comp: 10-23-51

Casing
8 5/8" Set @ 250'

Cement
140 sacks of Lehig

Formation	Depth
Shale-Post rock	150
Shale-Shells	250
Shale-Shells	460
Shale-Pyrite	480
Shale-Shells-Redbed	734
Anhydrite	745
Anhydrite	761
Shale-Anhydrite	826
Shale-Shells	950
Shale-Redbed-Shells	1007
Shale-Shells	1110
Shale-Lime	1170
Shale-Salt	1420
Shale-Lime	1581
Shale-Lime	1788
Lime	1896
Shale-Lime	1907
Lime	2018
Shale-Lime	2730
Lime	2745
Lime-Shale	2823
Lime	2959
Lime-Shale	3040
Lime	3315
Lime-Shale	3343
Congl.	3380
Lime	3436

STATE OF KANSAS)
) ss
RUSSELL COUNTY)

I hereby certify that the above information is true
and correct to the best of my knowledge.

Cora Betty

Subscribed and sworn to before me this 31st day of October, 1951

Christina

Notary Public

My commission expires: 6-17-54


RECEIVED
STATE CORPORATION COMMISSION
NOV - 1 1951
CONSERVATION DIVISION
WICHITA, KANSAS