


WELL PLUGGING RECORD

Give All Information Completely  
Make Required Affidavit  
Mail or Deliver Report to:  
Conservation Division  
State Corporation Commission  
211 No. Broadway  
Wichita, Kansas

NORTH

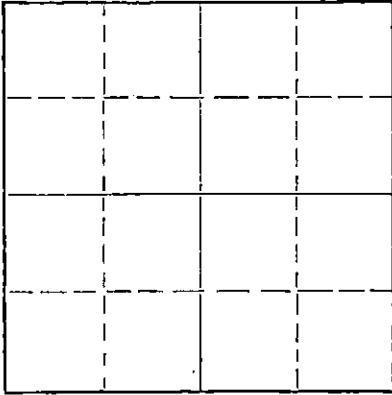

Locate well correctly on above  
Section Plat

Barton County. Sec. 15 Twp. 16S Rge. 11W (E// (W)  
Location as "NE/CNWxSWx" or footage from lines SE/NW/NE  
Lease Owner Wilkinson Drilling Company  
Lease Name Redetzke Well No. #2  
Office Address 818 E. 10th, Great Bend, Kansas  
Character of Well (completed as Oil, Gas or Dry Hole) \_\_\_\_\_  
Date well completed \_\_\_\_\_ 19\_\_\_\_  
Application for plugging filed Yes 19\_\_\_\_  
Application for plugging approved Yes 19\_\_\_\_  
Plugging commenced \_\_\_\_\_ 4-10 1959  
Plugging completed \_\_\_\_\_ 4-16 1959  
Reason for abandonment of well or producing formation \_\_\_\_\_

If a producing well is abandoned, date of last production \_\_\_\_\_ 19\_\_\_\_  
Was permission obtained from the Conservation Division or its agents before plugging was commenced? Yes

Name of Conservation Agent who supervised plugging of this well Mr. Donald Truan  
Producing formation \_\_\_\_\_ Depth to top \_\_\_\_\_ Bottom \_\_\_\_\_ Total Depth of Well 3343' Feet  
Show depth and thickness of all water, oil and gas formations.

OIL, GAS OR WATER RECORDS

CASING RECORD

FORMATION	CONTENT	FROM	TO	SIZE	PUT IN	PULLED OUT
				8 5/8"		
				5 1/2"		2,750'

Describe in detail the manner in which the well was plugged, indicating where the mud fluid was placed and the method or methods used in introducing it into the hole. If cement or other plugs were used, state the character of same and depth placed, from \_\_\_\_\_ feet to \_\_\_\_\_ feet for each plug set.

Measured into T.D. 3343'.  
Plugging started 4-10-59. Finished 4-16-59.  
Plugged off bottom and sanded from 3343' to 3320'. Dumped 5 sacks of cement. Worked and shot pipe. Shot 5 1/2" casing at 2,750'. Pulled pipe out of hole and plugged well as follows: Bailed down 8 5/8" to 400'. Mudded to 300'. Set rock bridge and dumped 25 sacks of cement. Filled hole with mud to 40'. Set rock bridge and mixed 10 sacks of cement for cap on well. Well completed.

RECEIVED  
STATE CORPORATION COMMISSION  
MAY 5 5-5-1959  
CONSERVATION DIVISION  
Wichita, Kansas

(If additional description is necessary, use BACK of this sheet)  
Name of Plugging Contractor J.O. Forbes d/h/a Forbes Casing Pulling Co.  
Address Box 221, Great Bend, Kansas

STATE OF Kansas, COUNTY OF Barton, ss.  
J.O. Forbes (employee of owner) or (owner or operator) of the above-described well, being first duly sworn on oath, says: That I have knowledge of the facts, statements, and matters herein contained and the log of the above-described well as filed and that the same are true and correct. So help me God.

(Signature) J.O. Forbes  
Box 221, Great Bend, Kansas  
(Address)

SUBSCRIBED AND SWORN TO before me this 30th day of April, 1959

Petty S. Edman  
Notary Public.

My commission expires November 8, 1960.

APR 30 REC'D

PLUGGING  
FILE SEC. 15T.16. R114  
BOOK PAGE 28 LINE 10

15-0907401-00-00

WILKINSON DRILLING INCORPORATED  
1121 UNION NATIONAL BUILDING  
WICHITA 2, KANSAS

REDETZKE #2

Company:	Wilkinson Drilling, Inc.	Location:	SE/4 NW/4 NE/4
Contractor:	Company Tools		Section 15-16S-11W
Commenced:	October 5, 1957		Barton County, Kansas
Completed:	October 15, 1957	Elevation:	1882 KB
Total Depth:	3343'	Casing:	20 joints 8 5/8" casing

FIGURES INDICATE BOTTOMS OF FORMATIONS

0 - 65	Surface soil and post rock
65 - 370	Clay and shale
370 - 400	Blue shale
400 - 515	Shale and shells
515 - 710	Shale, shells and red beds
710 - 740	Anhydrite
740 - 1440	Shale and shells
1440 - 1980	Shale and lime
1980 - 2060	Lime and shale
2060 - 2695	Shale and lime
2695 - 3000	Lime and shale
3000 - 3334	Lime
3334 - 3343	Arbuckle
3343 - TD	

**RECEIVED**  
STATE CORPORATION COMMISSION  
APR 8 1959  
CONSERVATION DIVISION  
Wichita, Kansas

We hereby certify the above and foregoing to be a true and correct copy of the log on the Redetzke No. 2, located in the SE/4 NW/4 NE/4 of Section 15-16S-11W, Barton County, Kansas.

WILKINSON DRILLING INCORPORATED

*Walter M. Wilkinson*  
Walter M. Wilkinson - President

Subscribed and sworn to before me this 7th day of April, 1959.

*Carolyn K. Moore*  
Carolyn K. Moore

My commission expires January 2, 1961.

**PLUGGING**  
FILE SEC. 15 T. 16 R. 11W  
BOOK PAGE 28 LINE 10