

15-009-20769-0000

STATE OF KANSAS  
STATE CORPORATION COMMISSION

Form CP-4

Give All Information Completely  
Make Required Affidavit  
Mail or Deliver Report to:  
Conservation Division  
State Corporation Commission  
P. O. Box 17027  
Wichita, Kansas 67217  
NORTH

WELL PLUGGING RECORD

Barton County. Sec. 15 Twp. 16 Rge. 11 (E) W (W)

Location as "NE/CNWSW" or footage from lines NW NE SE

Lease Owner Loer Addis

Lease Name ESFELD Well No. 2

Office Address Box 8038 - Wichita, Kansas 67208

Character of Well (completed as Oil, Gas or Dry Hole) Dry Hole

Date well completed Nov. 15 1973

Application for plugging filed Nov. 15 1973

Application for plugging approved Nov. 15 1973


Plugging commenced Nov. 15 1973

Plugging completed Nov. 15 1973

Reason for abandonment of well or producing formation \_\_\_\_\_

If a producing well is abandoned, date of last production \_\_\_\_\_ 19\_\_\_\_

Was permission obtained from the Conservation Division or its agents before plugging was commenced? Yes

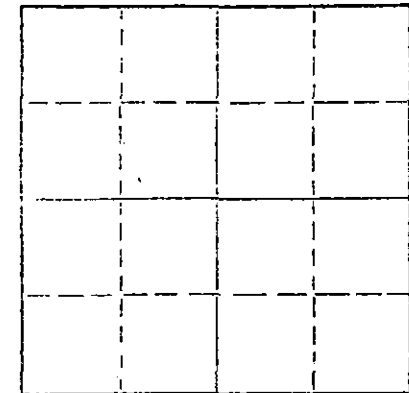

Locate well correctly on above Section Plat

Name of Conservation Agent who supervised plugging of this well DON TRUJAN

Producing formation \_\_\_\_\_ Depth to top \_\_\_\_\_ Bottom \_\_\_\_\_ Total Depth of Well 3350 Feet

Show depth and thickness of all water, oil and gas formations.

OIL, GAS OR WATER RECORDS

CASING RECORD

FORMATION	CONTENT	FROM	TO	SIZE	PUT IN	PULLED OUT

Describe in detail the manner in which the well was plugged, indicating where the mud fluid was placed and the method or methods used in introducing it into the hole. If cement or other plugs were used, state the character of same and depth placed, from \_\_\_\_\_ feet to \_\_\_\_\_ feet for each plug set.

Hole full of heavy mud. Set bottom plug at 480', with 40 sacks cement thru drill pipe.

Middle Plug set at 180' with 25 sacks cement thru drill pipe

Top Plug set at 40' with 1/2 sacks hulls, 10 sacks cement, 2 sacks cement in rat hole.

RECEIVED  
STATE CORPORATION COMMISSION  
NOV 20 1973  
CONSERVATION DIVISION  
Wichita, Kansas

(If additional description is necessary, use BACK of this sheet)

Name of Plugging Contractor \_\_\_\_\_

Address \_\_\_\_\_

STATE OF Kansas COUNTY OF Barton, ss.

Garry Curtis (employee of owner) or (~~owner~~) of the above-described well, being first duly sworn on oath, says: That I have knowledge of the facts, statements, and matters herein contained and the log of the above-described well as filed and that the same are true and correct. So help me God.

(Signature) Garry Curtis

Box 823 - Great Bend, Ks. 67530  
(Address)

SUBSCRIBED AND SWORN to before me this 19 day of November, 1973

4-11-1974

My commission expires \_\_\_\_\_

Blair M. Hague  
Notary Public.

15009-207690000

DRILLERS' WELL LOG

DATE COMMENCED: November 7, 1973  
DATE COMPLETED: November 15, 1973

Trer Addis  
ESFIELD #2  
NW NE SE of Sec. 15-16-11w  
Barton County, Kansas

ELEVATION: 1872 K.B.

0 - 45'	Clay & Post Rock
45 - 192'	Blue Shale
192 - 395'	Shale & Sand
395 - 697'	Red Bed
697 - 724'	Anhydrite
724 - 935'	Red Bed
936 - 1383'	Shale
1383 - 1775'	Shale & Lime streaks
1775 - 1870'	Lime
1870 - 2116'	Shale & Lime Streaks
2116 - 2611'	Shale
2611 - 2901'	Lime
2901 - 2906'	Shale
2906 - 2921'	Lime & Shale
2921 - 2934'	Lime
2934 - 2997'	Shale
2997 - 3011'	Br. Lime
3011 - 3309'	Lime
3309 - 3337'	Conglomerate
3337 - 3350'	Dolomite
3350'	RTD

FORMATION DATA

ANHYDRITE	697'
TOPEKA	2511
HEERDEN	2901
TORONTO	2921
DOUGLAS	2934
BROWN LIME	2997
KANSAS CITY	3011
BASE K.C.	3309
AREUCKLE	3337
RTD	3350

SURFACE PIPE: Set used 6-5/8" surface pipe at 192' with 150 sacks cement, 2 1/2 Gal, 3 1/2 GG.

AFFIDAVIT

STATE OF KANSAS  
COUNTY OF BARTON ss.

Larry Curtis of lawful age of sound mind, does swear and state that the facts and statements herein contained are true and correct to the best of his knowledge.

Subscribed and sworn to before me this 19<sup>th</sup> day of November 1973.

My Comm. Expires: April 11, 1974

Larry Curtis

Maithy M. Hague  
Notary Public

RECEIVED  
NOV 20 1973  
STATE CORPORATION COMMISSION  
CONSERVATION DIVISION  
Wichita, Kansas