


STATE OF KANSAS  
STATE CORPORATION COMMISSION  
CONSERVATION DIVISION  
P. O. BOX 17027  
WICHITA, KANSAS 67217

FORM CP-4

WELL PLUGGING RECORD

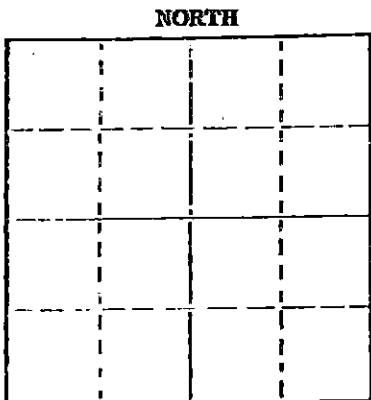

Locate well correctly on above Section Plat

Barton County, Sec. 16 Twp. 16 Rge. (E) 11 (W)  
Location as "NE/CNWSW" or footage from lines SW SW SE  
Lease Owner H-30 INC.  
Lease Name Esfeld Well No. 1  
Office Address 200 N. Main Wichita Kansas  
Character of Well (completed as Oil, Gas or Dry Hole) Oil  
Date well completed \_\_\_\_\_ 19 64  
Application for plugging filed 9/25 19 74  
Application for plugging approved 927 19 74  
Plugging commenced 9/30 19 74  
Plugging completed 10/3 19 74  
Reason for abandonment of well or producing formation dry

If a producing well is abandoned, date of last production 6/ 19 74  
Was permission obtained from the Conservation Division or its agents before plugging was commenced? Yes

Name of Conservation Agent who supervised plugging of this well Donald Truan  
Producing formation Arbuckle Depth to top 3325 Bottom 3333 Total Depth of Well 3334 Feet  
Show depth and thickness of all water, oil and gas formations.

OIL, GAS OR WATER RECORDS

CASING RECORD

FORMATION	CONTENT	FROM	TO	SIZE	PUT IN	PULLED OUT
	Surface	0	250	8 5/8		
		0	3327	4 1/2		

RECEIVED  
STATE CORPORATION COMMISSION  
OCT 7 1974  
10-7-74  
CONSERVATION DIVISION  
Wichita, Kansas

Describe in detail the manner in which the well was plugged, indicating where the mud fluid was placed and the method or methods used in introducing it into the hole. If cement or other plugs were used, state the character of same and depth placed, from \_\_\_\_\_ feet to \_\_\_\_\_ feet for each plug set.

Sand to 3200 with 4 sx. cement

~~3500 to 3500 with 4 sx. cement~~

Pumped with Allied cementers 1sx. hulls 20 sx. jell and 1sx. hulls & 100 sx cement

(If additional description is necessary, use BACK of this sheet)

Name of Plugging Contractor Nicholas Casing Pulling  
Address Box 373 Geneseo Kansas 67444

STATE OF KANSAS COUNTY OF Rice, ss.  
George A. Nicholas (employee of owner) or (owner or operator) of the above-described well, being first duly sworn on oath, says: That I have knowledge of the facts, statements, and matters herein contained and the log of the above-described well as filed and that the same are true and correct. So help me God.

(Signature) George A. Nicholas

(Address)

4th day of October 19 74

Sept 24, 1978

Warren H. Laughlin  
Notary Public.

