


Give All Information Completely
Make Required Affidavit
Mail or Deliver Report to:
Conservation Division
State Corporation Commission
800 Bittling Building
Wichita, Kansas

15009063500000

WELL PLUGGING RECORD

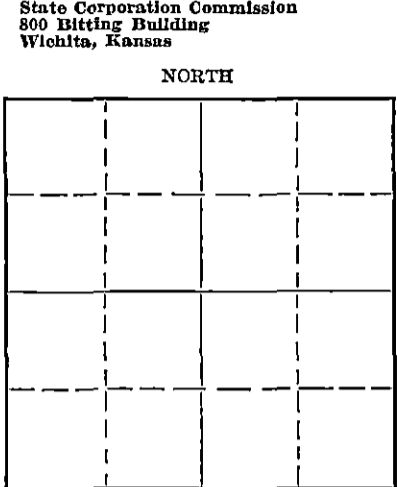

Locate well correctly on above Section Plat

Barton County, Sec. 16 Twp. 16 Rge. 11W (E) (W)
Location as "NE/CNW $\frac{1}{4}$ /SW $\frac{1}{4}$ " or footage from lines NE SW SE
Lease Owner Anschutz Drilling Company, Inc.
Lease Name Esfeld Well No. 1
Office Address 709 Union National Bank Bldg., Wichita, Kansas
Character of Well (completed as Oil, Gas or Dry Hole) Dry Hole
Date well completed 4/28 19 51
Application for plugging filed 4/28 19 51
Application for plugging approved 4/28 19 51
Plugging commenced 4/28 19 51
Plugging completed 4/28 19 51
Reason for abandonment of well or producing formation Dry Hole
If a producing well is abandoned, date of last production ---- 19
Was permission obtained from the Conservation Division or its agents before plugging was commenced? Yes

Name of Conservation Agent who supervised plugging of this well C. D. Stough, Great Bend, Kansas
Producing formation --- Depth to top --- Bottom --- Total Depth of Well 340 Feet
Show depth and thickness of all water, oil and gas formations.

OIL, GAS OR WATER RECORDS

CASING RECORD

Formation	Content	From	To	Size	Put In	Pulled Out
				8-5/8"	163'	-----

Describe in detail the manner in which the well was plugged, indicating where the mud fluid was placed and the method or methods used in introducing it into the hole. If cement or other plugs were used, state the character of same and depth placed, from --- feet to --- feet for each plug set.

Bottom plug set @ 161' with 15 sacks cement.
Top plug set @ 30' with 10 sacks cement.

RECEIVED
MAY 5 - 1951
5-5-51
CONSERVATION DIVISION
Wichita, Kansas

(If additional description is necessary, use BACK of this sheet)
Correspondence regarding this well should be addressed to Anschutz Drilling Company, Inc.
Address 709 Union National Bank Bldg., Wichita, Kansas

STATE OF Kansas, COUNTY OF Sedgwick, ss.
E. B. Snell (employee of owner) or (owner or operator) of the above-described well,
being first duly sworn on oath, says: That I have knowledge of the facts, statements, and matters herein contained and the log of the above-described well as filed and that the same are true and correct. So help me God.
(Signature) *E B Snell*
709 Union Nat'l. Bk. Bldg., Wichita, Ks.
(Address)

SUBSCRIBED AND SWORN to before me this 4th day of May, 19 51.
Patricia Meeker
Patricia Meeker Notary Public.

My commission expires January 21, 1954.
23-5091-s 8-50-10M

PLUGGING
FILE SEC 16 T 16 R 11W
BOOK PAGE 78 LINE 29

DRILLER'S LOG
ANSCHUTZ DRILLING COMPANY, INC.
#1 Esfeld
NE SW SE - Section 16-16S-11W
Barton County, Kansas

40	163	Shale & shells
163	320	Shale
320	415	Sand
415	485	Sand & shale
485	513	Sand & Pyrite
513	560	Shale & red bed
560	745	Shale
745	775	Anhydrite
775	1020	Shale
1020	1360	Shale
1360	1395	Shale & shells
1395	1525	Lime & shale
1525	1685	Lime & shale
1685	1805	Lime & shale
1805	1925	Shale & lime
1925	2030	Shale & shells
2030	2170	Shale & shells
2170	2275	Lime & shale
2275	2405	Shale & shells
2405	2515	Shale & shells
2515-	2615	Shale & shells
2615	2735	Shale & shells
2735	2815	Lime & shale
2815	3015	Lime & shale
3015	3047	Lime & shale
3047	3058	Lime
3058	3082	Lime
3082	3305	Lime
3305	3370	Lime & shale
3370	3390	Conglomerate
3390	3401	Arbuckle
3401		ROTARY TOTAL DEPTH

COMMENCED: 4/17/51
COMPLETED: 4/28/51

TOPS:

Heeb.	2934	(-1036)
Dodge	2954	
B. L.	3030	
Lans	3047	
Arb.	3390	
RTD	3401	

CASING RECORD:

Set 8-5/8" surface csg.
@ 163' with 100 sacks cement
and 1 CC.
D & A

STATE OF KANSAS)
) SS
COUNTY OF SEDGWICK)

I hereby affirm that the above and foregoing is a true and correct copy of the log of the #1 Esfeld located in the NE SW SE of Section 16-16S-11W, Barton County, Kansas.

STATE CORPORATION COMMISSION
MAY 5 - 1951
CONSERVATION DIVISION
Wichita, Kansas

ANSCHUTZ DRILLING COMPANY, INC.

BY: *E. B. Snell*
E. B. Snell

Subscribed and sworn to before me this 4th day of May, 1951.

L. A. Meeker
Notary Public

My commission expires: January 21, 1954.

PLUGGING
FILE SEC 16 T. 16 R. 11W
BOOK PAGE 78 LINE 29