


STATE OF KANSAS  
STATE CORPORATION COMMISSION

15-009-15169-0000

WELL PLUGGING RECORD

Give All Information Completely  
Make Required Affidavit  
Mail or Deliver Report to:  
Conservation Division  
State Corporation Commission  
800 Bittling Building  
Wichita, Kansas

NORTH

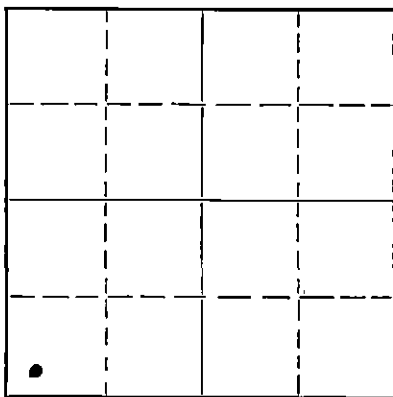

Locate well correctly on above  
Section Plat

Barton County. Sec. 16 Twp. 16 Rge. 11 (E) 11 (W)  
Location as "NE/CNW $\frac{1}{4}$ SW $\frac{1}{4}$ " or footage from lines SW SW SW  
Lease Owner Sinclair Oil & Gas Co  
Lease Name A.E. Redetzke Well No. 1  
Office Address Box 521, Tulsa, Okla.  
Character of Well (completed as Oil, Gas or Dry Hole) Oil well  
Date well completed Mar 31 1939  
Application for plugging filed Apr 11 1951  
Application for plugging approved Apr 12 1951  
Plugging commenced Apr 14 1951  
Plugging completed Apr 18 1951  
Reason for abandonment of well or producing formation production depleted

If a producing well is abandoned, date of last production December 1950  
Was permission obtained from the Conservation Division or its agents before plugging was commenced? yes

Name of Conservation Agent who supervised plugging of this well C.D. Stough  
Producing formation Arbuckle Lime Depth to top 3306 Bottom          Total Depth of Well 3310 Feet  
Show depth and thickness of all water, oil and gas formations.

OIL, GAS OR WATER RECORDS

CASING RECORD

Formation	Content	From	To	Size	Put In	Pulled Out
Arbuckle Lime	dry	3306	3310	10"	112'	0
				5-1/2"	3339	0

Describe in detail the manner in which the well was plugged, indicating where the mud fluid was placed and the method or methods used in introducing it into the hole. If cement or other plugs were used, state the character of same and depth placed, from          feet to          feet for each plug set.

Plugged back from 3310' to 1484' by previous work over operations; i.e. numerous cement squeeze jobs in unsuccessful attempts to close casing leaks.

Plugging completed from 1484' to bottom cellar with 500 sx cement.

RECEIVED  
STATE CORPORATION COMMISSION  
APR 27 1951  
CONSERVATION DIVISION

(If additional description is necessary, use BACK of this sheet)

Correspondence regarding this well should be addressed to Mr. E.H. Gibbons  
Address Box 551, Chase, Kas

STATE OF Kansas, COUNTY OF Rice, ss.  
I, E.H. Gibbons (employee of owner) or (owner) of the above-described well,

being first duly sworn on oath, says: That I have knowledge of the facts, statements, and matters herein contained and the log of the above-described well as filed and that the same are true and correct. So help me God.

(Signature) E.H. Gibbons

Box 551, Chase, Kas  
(Address)

SUBSCRIBED AND SWORN to before me this 25th day of April, 1951

My commission expires Aug 22, 1953

B.J. Ritterhouse  
Notary Public.

PLUGGING  
FILE SEC 16 T 16 R 11 W  
BOOK PAGE 73 LINE 6

15-009-15169-0000

# SINCLAIR OIL & GAS COMPANY

SINCLAIR OIL & GAS COMPANY  
 Anton E. REDETZKE - Well No. 1  
 SW-SW-SW  
 Sec: 16 - 16S - 11W  
 Barton County - KANSAS  
 (Kraft-Prusa (Arbuckle))

LOCATION: March 8, 1939  
 DRILLING COMMENCED: March 12, 1939  
 DRILLING COMPLETED: March 31, 1939  
 CONTRACTOR: Harbar Drilling Company  
 Wichita, Kansas  
 COMMENCED PRODUCING: April 17, 1939  
 TOTAL DEPTH - 3310'  
 INITIAL POTENTIAL 50.41-bbls

ELEVATION - 1881' (DF)

## Driller's Log

<u>Formation</u>	<u>Total Depth</u>
Sand, Rock & Clay	105'
Lime Shells	111'
Shale & Shells	280'
Sand	300'
Shale & Shells	355'
Sand	395'
Shale & Shells	1160'
Salt & Shale	1400'
Shale & Shells	1475'
Broken Lime & Shale	1575'
Lime & Shale	1780'
Lime	1835'
Lime & Shale	1995'
Shale & Shells	2060'
Broken Lime	2090'
Broken Lime & Shale	2165'
Shale & Lime Shells	2275'
Broken Lime & Shale	2355'
Lime & Shale	2410'
Shale & Shells	2515'
Lime & Shale	2660'
Lime	2920'
Broken Lime	2943'
Shale	3005'
Lime	3312½' (PB 2½' Cement not drilled Out)
	3310' (TD at Completion)
Arbuckle Lime (Top)	3306'
5½" Set @	3306' Cemented w/ 150-Sacks
10" Surface Casing Set @	111' - Cemented w/ 100-Sacks

Last Date Produced - Nov. 28th, 1950  
 Well failed when 5½" Casing developed leaks in  
 Salt and Water zones.

**PLUGGING**  
 FILE SEC 16T16R11W  
 BOOK PAGE 73 LINE 6

APR 12 1951  
 CONSERVATION DIVISION  
 Wichita, Kansas