


Give All Information Completely
Make Required Affidavit
Mail or Deliver Report to:
Conservation Division
State Corporation Commission
211 No. Broadway
Wichita, Kansas

WELL PLUGGING RECORD 15-009-203590000

NORTH

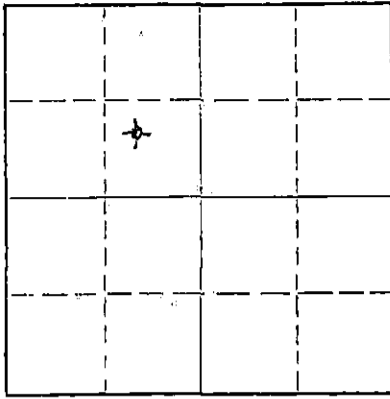

Locate well correctly on above
Section Plat

Barton County, Sec. 16 Twp. 16S Rge. (E) 11 (W)
Location as "NE/CNW/SW" or footage from lines 50' E of NW SE NW
Lease Owner Lario Oil & Gas Company
Lease Name Albert H. Oeser Well No. 1
Office Address 301 S. Market, Wichita, Kansas 67202
Character of Well (completed as Oil, Gas or Dry Hole) Dry
Date well completed April 21 1969
Application for plugging filed (Verbal) April 21 1969
Application for plugging approved (Verbal) April 21 1969
Plugging commenced April 21 1969
Plugging completed April 21 1969
Reason for abandonment of well or producing formation Dry

If a producing well is abandoned, date of last production 19
Was permission obtained from the Conservation Division or its agents before plugging was commenced? Yes

Name of Conservation Agent who supervised plugging of this well Donald Truan
Producing formation _____ Depth to top _____ Bottom _____ Total Depth of Well 3350 Feet
Show depth and thickness of all water, oil and gas formations.

OIL, GAS OR WATER RECORDS

CASING RECORD

FORMATION	CONTENT	FROM	TO	SIZE	PUT IN	PULLED OUT
				8 5/8	759	None

Describe in detail the manner in which the well was plugged, indicating where the mud fluid was placed and the method or methods used in introducing it into the hole. If cement or other plugs were used, state the character of same and depth placed, from _____ feet to _____ feet for each plug set.

Plug @ 350'. 25 sacks cement. Mud to 40'. Plug 1/2 sack hulls. 10 sacks cement. 3 sacks in rat hole.

RECEIVED
STATE CORPORATION COMMISSION
APR 25 1969
CONSERVATION DIVISION
Wichita, Kansas
4-25-69

(If additional description is necessary, use BACK of this sheet)

Name of Plugging Contractor Dunne-Gardner Petroleum, Inc.
Address 300 Schweiter Building, Wichita, Kansas 67202

STATE OF Kansas, COUNTY OF Sedgwick, ss.
Orville H. Hinerman, Jr. (employee of owner) or (owner) of the above-described well, being first duly sworn on oath, says: That I have knowledge of the facts, statements, and matters herein contained and the log of the above-described well as filed and that the same are true and correct. So help me God.

(Signature) Orville H. Hinerman, Jr.
301 S. Market, Wichita, Kansas 67202
(Address)

SUBSCRIBED AND SWORN TO before me this 23rd day of April, 1969

Frances Leabe
Notary Public.

My commission expires July 21, 1970

15009-20359-0000

Lario Oil & Gas Company
Albert H. Oeser No. 1
50' E of NW SE NW Sec. 16-16S-11W
Barton County, Kansas

Drilling Commenced: April 14, 1969
Drilling Completed: April 21, 1969
Drilling Contractor: Dunne-Gardner Petroleum, Inc.
Total Depth: 3350'
D & A

<u>Formation</u>	<u>Depth</u>	<u>Casing Record:</u>
Lime	115	8 5/8" 765' Set @ 759' Cem. w/
Shale & shells	425	400 sacks
Shale	560	
Red Bed	701	
Anhydrite	708	
Shale	1395	<u>Geological Tops:</u>
Shale & lime	1675	Heebner 2906' (-1055')
Lime	1955	Toronto 2925' (-1074')
Lime & shale	1985	Douglas 2941' (-1090')
Shale & lime	2240	Brown lime 3005' (-1154')
Broken lime	2525	Lansing 3020' (-1170')
Shale & lime	2808	Base Kansas City 3283' (-1432')
Lime	3335	Conglomerate 3312' (-1461')
Lime & shale	3350	Total Depth 3350' (-1499')

RECEIVED
STATE CORPORATION COMMISSION
APR 25 1969
CONSERVATION DIVISION
Wichita, Kansas