

WELL PLUGGING RECORD

Give All Information Completely
Make Required Affidavit
Mail or Deliver Report to:
Conservation Division
State Corporation Commission
211 No. Broadway
Wichita, Kansas

Kearny County, Sec. 16 Twp. 24S Rge. 37 (E) (W)
C NW/4, SE/4

Location as "NE/CNW/SW" or footage from lines

Lease Owner Pan American Petroleum Corporation

Lease Name Vernon G. Kropp "B" Well No. 1

Office Address P. O. Box 507, Ulysses, Kansas

Character of Well (completed as Oil, Gas or Dry Hole) Dry Hole

Date well completed 2-17 19 63

Application for plugging filed 2-17 19 63

Application for plugging approved 2-17 19 63


Plugging commenced 2-17 19 63

Plugging completed 2-17 19 63

Reason for abandonment of well or producing formation No productive oil or gas zones were encountered.

If a producing well is abandoned, date of last production 19

Was permission obtained from the Conservation Division or its agents before plugging was commenced? yes

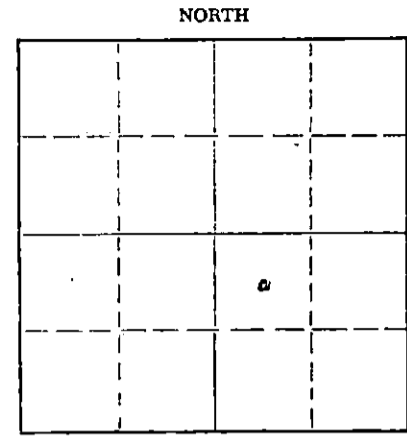

Locate well correctly on above Section Plat

Name of Conservation Agent who supervised plugging of this well Hugh Scott

Producing formation Depth to top Bottom Total Depth of Well 5280 Feet

Show depth and thickness of all water, oil and gas formations.

OIL, GAS OR WATER RECORDS

CASING RECORD

FORMATION	CONTENT	FROM top	TO	SIZE	PUT IN	PULLED OUT
Council Grove	Water	2858		8-5/8	2112	None
Des Moines	Water	4488				
Morrow	Water	4845				

Describe in detail the manner in which the well was plugged, indicating where the mud fluid was placed and the method or methods used in introducing it into the hole. If cement or other plugs were used, state the character of same and depth placed, from feet to feet for each plug set.

- Hvy Mud - 5280-2850
- 165 Sx Cement - 2850-2550
- Hvy Mud - 2550-650
- 20 sx Cement - 650-600
- Hvy Mud - 600-30
- 10 sx Cement - 30-0

RECEIVED BY
STATE CORPORATION COMMISSION

FEB 27 1963 2-27-63

CONSERVATION DIVISION
Wichita, Kansas

(If additional description is necessary, use BACK of this sheet)

Name of Plugging Contractor Big Chief Drl Co.

Address Oklahoma City, Oklahoma

STATE OF Kansas, COUNTY OF Grant, ss. I, D. M. Liles

(employee of owner) or (owner or operator) of the above-described well, being first duly sworn on oath, says: That I have knowledge of the facts, statements, and matters herein contained and the log of the above-described well as filed and that the same are true and correct. So help me God.

(Signature) [Signature]

P. O. Box 507, Ulysses, Kansas (Address)

SUBSCRIBED AND SWORN TO before me this 22nd day of February, 1963

My commission expires 12-3-64

R. W. Banks Notary Public.

PAN AMERICAN PETROLEUM CORPORATION

WELL RECORD

SUPPLEMENTAL (ENTER "X" WHEN APPLICABLE)

Grid for locating well correctly

LOCATE WELL CORRECTLY

LEASE Vernon G. Kropp "B" WELL NO. 1
LOCATION OF WELL: 1980 FT. NORTH SOUTH OF THE NORTH SOUTH LINE AND 1980 FT.
EAST WEST OF THE EAST WEST LINE OF THE 1/4 SE 1/4.
OF SECTION 16 TOWNSHIP 24 NORTH SOUTH. RANGE 37 EAST WEST.
Kearny Kansas
COUNTY STATE
ELEVATION: Ground 3266 RDB3275
COMPLETED AS: OIL WELL GAS WELL WATER WELL DRY HOLE
DRILLING COMMENCED 1-27 1963 COMPLETED 2-17 1963

OPERATING COMPANY Pan American Petroleum Corporation ADDRESS Box 507, Ulysses, Kansas

OIL OR GAS SANDS OR ZONES

Table with columns: NAME, FROM, TO, NAME, FROM, TO. Includes Council Grove, Des Moines, Morrow.

RECEIVED STATE CORPORATION COMMISSION FEB 27 1963 CONSERVATION DIVISION Wichita, Kansas

WATER SANDS

Table with columns: NAME, FROM, TO, WATER LEVEL, NAME, FROM, TO, WATER LEVEL. Includes Not known.

CASING RECORD (OVERALL MEASUREMENT)

LINER-SCREEN RECORD

Table with columns: CSG. SIZE, WEIGHT, THREADS, MAKE - GRADE, QUANTITY FEET, SIZE, QUANTITY FEET, SET AT TOP, SET AT BOTTOM, MAKE AND TYPE.

PACKER RECORD

Table with columns: SIZE, LENGTH, SET AT, MAKE AND TYPE.

CEMENTING RECORD

MUDDING RECORD

Table with columns: SIZE, WHERE SET FEET, SACKS, CEMENT BRAND, TYPE, METHOD, FINAL PRESS, METHOD, RESULTS.

WHAT METHOD WAS USED TO PROTECT SANDS WHEN OUTER STRINGS WERE PULLED?

WERE BOTTOM HOLE PLUGS USED?

IF SO, STATE KIND, DEPTH SET, AND RESULTS OBTAINED

ROTARY TOOLS WERE USED FROM 0 FEET TO 5280 FEET, AND FROM FEET TO FEET

CABLE TOOLS WERE USED FROM None FEET TO FEET, AND FROM FEET TO FEET

24-HOUR PRODUCTION OR POTENTIAL TEST Dry Hole

WATER BBLs.

IF GAS WELL, CUBIC FEET PER 24 HOURS SHUT-IN PRESSURE LBS. PER SQUARE IN.

I, THE UNDERSIGNED, BEING FIRST DULY SWORN UPON OATH, STATE THAT THIS WELL RECORD IS TRUE AND CORRECT ACCORDING TO THE RECORDS OF THIS OFFICE AND TO THE BEST OF MY KNOWLEDGE AND BELIEF.

SUBSCRIBED AND SWORN TO BEFORE ME THIS 22nd DAY OF February 1964 MY COMMISSION EXPIRES 12-3-64 R. W. Banks NOTARY PUBLIC

Area Suppt.

(NAME AND TITLE)

NOTARY PUBLIC

FORMATION RECORD

DESCRIBE EACH FORMATION DRILLED. INDICATE THICKNESS, CONTENT AND WHETHER DRY, OR OIL, GAS, OR WATER BEARING.

FORMATION	TOP	BOTTOM	FORMATION	TOP	BOTTOM
Surface Sand, Red Bed	0	550			
Red Bed	550	725			
Red Bed, Shale	725	1073			
Shale, Anhydrite	1150	1926			
Lime, Shale	1926	2100			
Shale	2100	2511			
Lime, Shale	2511	3080			
Lime	3080	3301			
Chalk, Lime	3301	3440			
Lime, Shale	3440	3524			
Lime	3524	3615			
Lime, Chalk	3615	3778			
Lime, Shale	3778	3897			
Lime	3897				