


Your File Copy 15-095-01813-0000

STATE OF KANSAS  
STATE CORPORATION COMMISSION

Give All Information Completely  
Make Required Affidavit  
Mail or Deliver Report to:  
Conservation Division  
State Corporation Commission  
12 North Market, Insurance Bldg.  
Wichita, Kansas

WELL PLUGGING RECORD

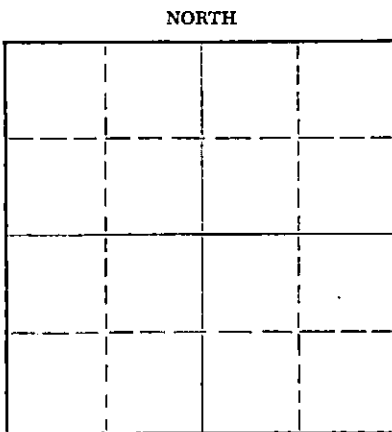

Locate well correctly on above Section Plat

Kingman County. Sec. 6 Twp. 30S Rge. (E) 8 (W)  
Location as "NE/CNW/SW" or footage from lines SE SW SE  
Lease Owner Pickrell Drilling Company  
Lease Name Hageman Well No. 2  
Office Address 705 Fourth National Bank Bldg., Wichita, Kansas  
Character of Well (completed as Oil, Gas or Dry Hole) Dry Hole  
Date well completed December 10, 1960  
Application for plugging filed December 10, 1960  
Application for plugging approved December 10, 1960  
Plugging commenced December 10, 1960  
Plugging completed December 10, 1960  
Reason for abandonment of well or producing formation Dry Hole

If a producing well is abandoned, date of last production 19  
Was permission obtained from the Conservation Division or its agents before plugging was commenced? Yes

Name of Conservation Agent who supervised plugging of this well Fred W. Hampel, Pretty Prairie, Kansas  
Producing formation Depth to top Bottom Total Depth of Well 4285 Feet  
Show depth and thickness of all water, oil and gas formations.

OIL, GAS OR WATER RECORDS

CASING RECORD

| FORMATION | CONTENT | FROM | TO | SIZE   | PUT IN | PULLED OUT |
|-----------|---------|------|----|--------|--------|------------|
|           |         |      |    | 8 5/8" | 240'   | None       |
|           |         |      |    |        |        |            |
|           |         |      |    |        |        |            |
Describe in detail the manner in which the well was plugged, indicating where the mud fluid was placed and the method or methods used in introducing it into the hole. If cement or other plugs were used, state the character of same and depth placed, from feet to feet for each plug set.

Heavy mud to 240'. Set plug. Cement with 15 sks cement. Heavy mud to 65'. Set plug and cement with 18 sks cement to bottom of cellar. Plug rat hole with 2 sks cement.

RECEIVED  
STATE CORPORATION COMMISSION

DEC 19 1960  
12-19-60  
CONSERVATION DIVISION  
Wichita, Kansas

(If additional description is necessary, use BACK of this sheet)

Name of Plugging Contractor Pickrell Drilling Company  
Address 705 Fourth National Bank Building, Wichita, Kansas

STATE OF Kansas, COUNTY OF Sedgwick, ss.  
C. W. Sebitts (employee of owner) or (owner or operator) of the above-described well, being first duly sworn on oath, says: That I have knowledge of the facts, statements, and matters herein contained and the log of the above-described well as filed and that the same are true and correct. So help me God.

(Signature) *C. W. Sebitts*  
C. W. Sebitts  
705 Fourth National Bank Bldg., Wichita, Kans.  
(Address)

SUBSCRIBED AND SWORN TO before me this 15th day of December, 1960

*Marilyn A. Davis*  
Marilyn A. Davis  
Notary Public.

My commission expires March 7, 1964

15-095-01813-0000

ROTARY DRILLING LOG

COMPANY: Pickrell Drilling Company  
705 Fourth National Bank Building  
Wichita, Kansas  
LOCATION: HAGEMAN #2 - SE SW SE, Sec. 6-30S-8W  
Kingman County, Kansas

Rotary Drilling Commenced 11-28-60  
Rotary Drilling Completed 12-10-60

CONTRACTOR: **PICKRELL DRILLING COMPANY**  
Wichita, Kansas

CASING RECORD: Ran 6 jts. 8 5/8" Spiralweld, 200' 17#, 40' 19#. Set @ 240'  
with 165 sks cement. Circ.  
D & A, no oil string.

LOG

(Figures indicate bottom of formation — measurements from top of rotary bushing.)

|      |                   |                              |
|------|-------------------|------------------------------|
| 35   | Sand              | <u>Circulate for Samples</u> |
| 236  | Red rock          |                              |
| 315  | Shale             | 4121                         |
| 1040 | Red rock, shale   | 4131                         |
| 1150 | Shale             | 4141                         |
| 1450 | Lime, shale       | 4151                         |
| 1960 | Lime              | 4184                         |
| 3255 | Lime, shale       | 4195                         |
| 3445 | Lime, shale, sand | 4216                         |
| 3938 | Lime              | 4229                         |
| 4113 | Lime, shale       | 4285                         |
| 4285 | Miss. T.D.        |                              |

Slope Test

240 - 0°  
2100 - 0°  
3500 - 0°  
4184 - 0°

S.L.M.

230 - OK  
1800 - OK  
3126 - OK  
4184 - OK

**RECEIVED**  
STATE CORPORATION COMMISSION

DEC 19 1960

CONSERVATION DIVISION  
Wichita, Kansas

The undersigned, C. W. Sebitts, Attorney-in-Fact for PICKRELL DRILLING COMPANY, hereby certifies in behalf of said Company, that the above is a true and correct log of the formation encountered in drilling the above well as reflected by the Daily Drilling Reports.

**PICKRELL DRILLING COMPANY**

By *C. W. Sebitts*  
Attorney-in-Fact

STATE OF KANSAS }  
COUNTY OF SEDGWICK } ss.:

On this 15th day of December, 1960, before me the undersigned, a Notary Public, in and for the County and State aforesaid, personally appeared C. W. Sebitts, to me known to be the identical person who subscribed the name of PICKRELL DRILLING COMPANY to the foregoing instrument as its Attorney-in-Fact and acknowledged to me that he executed the same as his free and voluntary act and deed, and as the free and voluntary act and deed of such company, for the uses and purposes therein set forth.

Given under my hand and seal of office the day and year last above written.

My commission expires: March 7, 1964

*Marilyn A. Davis*  
Notary Public  
Marilyn A. Davis