

STATE OF KANSAS
STATE CORPORATION COMMISSION

WELL PLUGGING RECORD

Give All Information Completely
Make Required Affidavit
Mail or Deliver Report to:
Conservation Division
State Corporation Commission
800 Biting Building
Wichita, Kansas

Kingman County, Sec. 12 Twp. 30 Rge. (E) 8 (W)

Location as "NE/CNW/SW" or footage from lines NE NE NE

Lease Owner Murphy Oil Co. of Oklahoma, Inc.

Lease Name Young Well No. 1

Office Address 400 Midstates Bldg., Tulsa, Okla.

Character of Well (completed as Oil, Gas or Dry Hole) Dry Hole

Date well completed February 6, 1955 1955

Application for plugging filed 19

Application for plugging approved March 21 1955

Plugging commenced March 1 1955


Plugging completed March 15 1955

Reason for abandonment of well or producing formation Non-Commercial show
Dry Hole

If a producing well is abandoned, date of last production None 19

Was permission obtained from the Conservation Division or its agents before plugging was commenced? Yes

NORTH

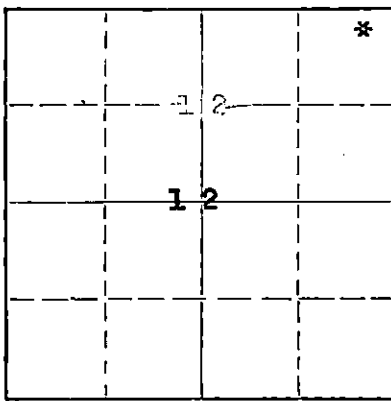

Locate well correctly on above Section Plat

Name of Conservation Agent who supervised plugging of this well Ruel Durkee

Producing formation None Depth to top Bottom Total Depth of Well Feet

Show depth and thickness of all water, oil and gas formations.

OIL, GAS OR WATER RECORDS

CASING RECORD

FORMATION	CONTENT	FROM	TO	SIZE	PUT IN	PULLED OUT
Mississippi Chat	Show of oil & gas	4118	4146	10-3/4" 7"	311' 4340'	None 3000'

Describe in detail the manner in which the well was plugged, indicating where the mud fluid was placed and the method or methods used in introducing it into the hole. If cement or other plugs were used, state the character of same and depth placed, from feet to feet for each plug set.

Plug back with fine sand from 4168 to 4010, dumped 6 sacks of cement with bailer at 4010. Mudded hole to 250' ran 10' of rock bridge and dumped 20 sacks of cement. Mudded hole to 15' and dumped 15 sacks of cement according to State of Kansas plugging orders.

3-25-55

(If additional description is necessary, use BACK of this sheet)

Name of Plugging Contractor E & L Casing Pulling Co.

Address Great Bend, Kansas

STATE OF Oklahoma, COUNTY OF Tulsa, ss.

(employee of owner) or (owner or operator) of the above-described well, being first duly sworn on oath, says: That I have knowledge of the facts, statements, and matters herein contained and the log of the above-described well as filed and that the same are true and correct. So help me God.

(Signature) J. A. McCalla
400 Midstates Bldg., Tulsa 3, Oklahoma
(Address)

SUBSCRIBED AND SWORN to before me this 24th day of March, 1955

My commission expires

My commission expires Oct. 12, 1958

W. Louis Bates
Notary Public.

PLUGGING
FILE SEC 12 T 30 R 8W
BOOK PAGE 106 JUNE 2

LOG NO.

NE NE NE Section 12-36-54
Kingman County, Kansas
Murphy Oil Company of Oklahoma, Inc.

10-3/4" O. D. casing cemented at 311'
7" O. D. casing cemented at 4351'

Drilling commenced January 17, 1955
Drilling completed February 6, 1955

FROM	TO	FORMATION	REMARKS
0'	70'	Sand & shale	
70	325	Red bed	10-3/4" O. D. casing cemented with 225 sacks cement at 311'
325	375	Red bed & shale	
375	390	Sand	
390	1175	Shale & shells	
1175	1375	Shale & anhydrite	
1375	1545	Lime & shale	
1545	1700	Lime	
1700	2105	Lime & shale	
2105	2365	Shale & shells	
2365	2675	Shale & lime	
2675	2778	Lime & shale	
2778	3205	Lime	
3205	3270	Lime & sand	
3270	3384	Sand & lime	
3384	3870	Lime	
3870	3991	Lime & shale	
3991	4047	Shale & lime	
4047	4127	Lime & shale	
4127	4152	Chert	
4152	4187	Chert & shale	
4187	4230	Lime & shale	
4230	4278	Lime	
4278	4448	Lime & shale	
4448	4520	Shale	
4520	4562	Lime & sand	
4562	4586	Hard sand	
4586	4616	Hard sand & shale	
4616	4649	Sand & shale	
4649	4680	Lime	10" O. D. casing cemented with 200 sacks cement at 4351'

T.D. 4680'

This is a true copy of the original log as shown on the following sheets.

WALTER JAMES BURST
Walter James Burst

Subscribed and sworn to before me on this 11th day of February, 1955.

Walter James Burst

My commission expires: July 27, 1957

PLUGGING
FILED FEB 12 1955
BOOK PAGE 106

3-25-55