


Give All Information Completely
Make Required Affidavit
Mail or Deliver Report to:
Conservation Division
State Corporation Commission
860 Bitting Building
Wichita, Kansas

WELL PLUGGING RECORD
OR
FORMATION PLUGGING RECORD

15-009-013480000

Strike out upper line when reporting plugging of formations.

NORTH

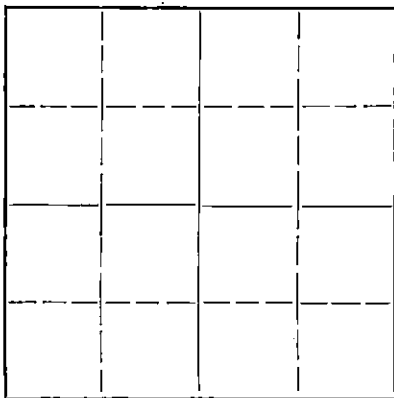

Locate well correctly on above Section Plat

Barton County, Sec. 10 Twp. 16 Rge. (E) 11 (W)

Location as "NE $\frac{1}{4}$ NW $\frac{1}{4}$ SW $\frac{1}{4}$ " or footage from lines NEc SE NW

Lease Owner Lauck & Moncrief

Lease Name Redetzke Well No. 1

Office Address 520 Fourth Nat'l Bank Bldg. Wichita Kans.

Character of Well (completed as Oil, Gas or Dry Hole) dry hole

Date well completed August 13 19 44

Application for plugging filed August 13 19 44

Application for plugging approved August 13 19 44

Plugging commenced August 13 19 44

Plugging completed August 13 19 44

Reason for abandonment of well or producing formation

If a producing well is abandoned, date of last production 19

Was permission obtained from the Conservation Division or its agents before plugging was commenced? yes

Name of Conservation Agent who supervised plugging of this well Petty

Producing formation none Depth to top Bottom Total Depth of Well 3367 Feet

Show depth and thickness of all water, oil and gas formations.


OIL, GAS OR WATER RECORDS

CASING RECORD

Formation	Content	From	To	Size	Put In	Pulled Out
Arbuckle	water	3354	3367	10"	188	none

Describe in detail the manner in which the well was plugged, indicating where the mud fluid was placed and the method or methods used in introducing it into the hold. If cement or other plugs were used, state the character of same and depth placed, from feet to feet for each plug set.

Mud 3367 to 188
cement 188 to 165
mud 165 to 25
cement 25 6' bottom of cellar

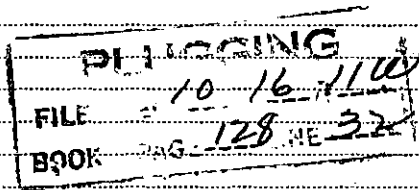

(If additional description is necessary, use BACK of this sheet)

Correspondence regarding this well should be addressed to Lauck & Moncrief
Address 520 Fourth Nat'l Bank Bldg. Wichita, Kans.

STATE OF Kansas, COUNTY OF Sedgwick, ss.
E. C. Moncrief, (owner or operator) of the above-described well,

being first duly sworn on oath, says: That I have knowledge of the facts, statements, and matters herein contained and the log of the above-described well as filed and that the same are true and correct. So help me God.

(Signature) E. C. Moncrief

520 Fourth Nat'l Bldg. Wichita Kans

(Address)

SUBSCRIBED AND SWORN to before me this 1st day of September, 19 44

My commission expires 1947

Elizabeth Gay
Notary Public

15-009-013480000

LAUCK & MONCRIEF et.al.

Redetzke No.1

Sec. 10 Twp.16S R11W NEc SE NW
Commenced July 30, 1944

Barton County Kansas
Completed Aug. 13, 1944

CASING:
10" 188' cemented 120Sacks.

Shale	250
red rock	300
shale	675
Anhydrite	695
Shale	770
shale & shells	850
red rock	1180
salt	1390
shale & lime	1480
shale & shells	1540
broken lime	1715
lime	1835
shale & lime	1890
lime	2185
lime & shale	2385
lime	3278
variegated shale	32 89
lime & shale	3302
Sandy Conglomerate	3320
Cherty Conglomerate	3355
Reworked Arbuckle	3363
Arbuckle	3367
Total Depth	

Tops: Derrick Floor

Lansing:	3017
Sandy Conglomerate	3301
Cherty Conglomerate	3319
Reworked Arbuckle	3354
Solid Arbuckle	3362

D & A

PLUGGING
 FILE = 10 16 R11W
 BOOK PAGE 128 LINE 32

STATE CORPORATION
 COMMISSIONER
 SEP - 2 1944
 CONSERVATION
 DIVISION