

15-209-00479-0000


FORMATION PLUGGING RECORD

Strike out upper line when reporting plugging of formations.

Give All Information Completely
Make Required Affidavit
Mail or Deliver Report to:
Conservation Division
State Corporation Commission
800 Biting Building
Wichita, Kansas

Barton County. Sec. 10 Twp. 16S Rge. 11 (E) (W)
Location as "NE $\frac{1}{4}$ NW $\frac{1}{4}$ SW $\frac{1}{4}$ " or footage from lines. C N 1/2 NW 1/4 NW 1/4
Lease Owner. G. W. Keyes Drilling Company
Lease Name. Redetzke Well No. 1
Office Address. Box 875, Ellinwood, Kansas
Character of Well (completed as Oil, Gas or Dry Hole) Dry Hole
Date well completed. May 5, 1945 19
Application for plugging filed. May 5, 1945 19
Application for plugging approved. May 5, 1945 19
Plugging commenced. May 5, 1945 19
Plugging completed. May 5, 1945 19
Reason for abandonment of well or producing formation. Dry Hole
If a producing well is abandoned, date of last production. --- 19
Was permission obtained from the Conservation Division or its agents before plugging was commenced? Yes

NORTH

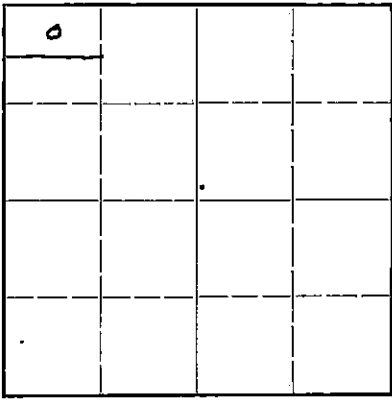

Locate well correctly on above Section Flat

Name of Conservation Agent who supervised plugging of this well. Mr. H. W. Kerr
Producing formation. --- Depth to top. --- Bottom. --- Total Depth of Well. 3370 Feet
Show depth and thickness of all water, oil and gas formations.

OIL, GAS OR WATER RECORDS

CASING RECORD

Formation	Content	From	To	Size	Put In	Pulled Out
Surface pipe		0	163'	8 5/8 OD	163'	none

Describe in detail the manner in which the well was plugged, indicating where the mud fluid was placed and the method or methods used in introducing it into the hold. If cement or other plugs were used, state the character of same and depth placed, from _____ feet to _____ feet for each plug set.

Hole was mudded back to 163', set bridge and cemented with 15 sacks. Mudded hole back to 20', set bridge, cut surface pipe off at base of cellar, cemented with 10 sacks, cement returning to base of cellar and covering surface pipe at point where it had been cut.



10 16 1000
12 33

(If additional description is necessary, use BACK of this sheet)

Correspondence regarding this well should be addressed to G. W. Keyes Drilling Company
Address Box 875, Ellinwood, Kansas

STATE OF Kansas, COUNTY OF Barton, ss.
I, G. W. Keyes (employee of owner) or (owner or operator) of the above-described well, being first duly sworn on oath, says: That I have knowledge of the facts, statements, and matters herein contained and the log of the above-described well as filed and that the same are true and correct. So help me God.

(Signature)

Ellinwood, Kansas
(Address)

SUBSCRIBED AND SWORN to before me this 9th day of May, 1945.

[Signature]
Notary Public.

My commission expires July 7, 1948

15009-06479-0000

WELL LOG

G. W. Keyes Drilling Company, Owner - Redetzke #1

C N 1/2 NW 1/4 NW 1/4 Section 10, Township 16 S, Range 11 W,
Barton County, Kansas

Unless otherwise specified figures indicate bottom of formation

0	to	40	Clay
		163	Shale and lime
		320	Shale and shells
		440	Red bed and shale
		720	Sand, shale
		745	Anhydrite
		1185	Shale and shells
		1280	Salt
		1400	Salt, shale and shells
		1440	Lime
		1780	Shale and shells
		1800	Shale
		2190	Lime
Started April 21, 1945		2315	Broken Lime
Abandoned May 5, 1945		2645	Shale and shells
		2710	Broken lime
		2950	Lime
Surface pipe 163' 8 5/8"		3010	Top brown lime
		3031	Top white lime, Lansing
		3315	Lime and shale
		3328	Top conglomerate
		3370	Total Depth still in conglomerate



State of Kansas)
County of Barton) ss

I, G. W. Keyes, Owner of the above-described well, being first duly sworn on oath, declare: That I have knowledge of the facts, statements and matters herein contained pertaining to the log of the above-described well as filed and that the same are true and correct.

G. W. Keyes

Subscribed and Sworn to before me this 9th day of May, 1945.

J. J. Rader
Notary Public.

10 16 11W
12 33

My commission expires July 7, 1948.