


STATE OF KANSAS
STATE CORPORATION COMMISSION

Give All Information Completely
Make Required Affidavit
Mail or Deliver Report to:
Conservation Division
State Corporation Commission
211 No. Broadway
Wichita, Kansas

WELL PLUGGING RECORD

15-009-01149-0000

NORTH

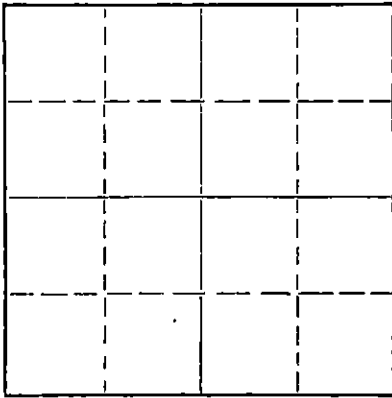

Locate well correctly on above
Section Flat

Barton County. Sec. 6 Twp. 16S Rge. (E) 11 (W)
Location as "NE/CNW/SW" or footage from lines NW NW SW
Lease Owner WILKINSON DRILLING, INC.
Lease Name WOYDZIAK Well No. 1
Office Address 1121 Union National Building, Wichita 2, Kansas
Character of Well (completed as Oil, Gas or Dry Hole) Dry
Date well completed October 2, 1958
Application for plugging filed October 2, 1958
Application for plugging approved October 2, 1958
Plugging commenced October 2, 1958
Plugging completed October 2, 1958
Reason for abandonment of well or producing formation No commercial quantity of gas and/or oil was encountered.
If a producing well is abandoned, date of last production -- 19--
Was permission obtained from the Conservation Division or its agents before plugging was commenced? Yes

Name of Conservation Agent who supervised plugging of this well Don Turon
Producing formation -- Depth to top -- Bottom -- Total Depth of Well -- Feet
Show depth and thickness of all water, oil and gas formations.

OIL, GAS OR WATER RECORDS

CASING RECORD

FORMATION	CONTENT	FROM	TO	SIZE	PUT IN	PULLED OUT

Describe in detail the manner in which the well was plugged, indicating where the mud fluid was placed and the method or methods used in introducing it into the hole. If cement or other plugs were used, state the character of same and depth placed, from feet to feet for each plug set.
Filled hole with heavy mud. Plugged at 350' with 1/4 sack Hulls and 25 sacks of cement through drill pipe. Plugged at 40' with 1/4 sack of Hulls and 10 sacks of cement through drill pipe.

STATE CORPORATION COMMISSION
10-28-58
OCT 28 1958
CONSERVATION DIVISION
Wichita, Kansas

(If additional description is necessary, use BACK of this sheet)
Name of Plugging Contractor WILKINSON DRILLING, INC.
Address 1121 Union National Building, Wichita 2, Kansas

STATE OF Kansas COUNTY OF Sedgwick ss.
Walter M. Wilkinson (employee of owner) or (owner or operator) of the above-described well, being first duly sworn on oath, says: That I have knowledge of the facts, statements, and matters herein contained and the log of the above-described well as filed and that the same are true and correct. So help me God.

(Signature) Walter M. Wilkinson
1121 Union National Bldg., Wichita 2, Kansas
(Address)

SUBSCRIBED AND SWORN TO before me this 27th day of October, 1958
Carolyn F. Moore Notary Public.

My commission expires Jan. 2, 1961

PLUGGING
FILE SEC. 6 T. 16 R. 11W
BOOK PAGE 139 LINE 40

15-009-01149-0000

WILKINSON DRILLING, INC.
1121 Union National Building
Wichita 2, Kansas

October 24, 1958

WOYDZIAK #1

Company	- WILKINSON DRILLING, INC.	Location	- NW NW SW, Sec. 6-16s-11w,
Contractor	- Company Tools		Barton County, Kansas
Commenced	- September 24, 1958	Elevation	- 1853' KB
Completed	- October 2, 1958	Casing	- 8 5/8" @ 397' w/225 sks Admix
Total Depth	- 3345'		

FIGURES INDICATE BOTTOMS OF FORMATIONS

<u>Depth</u>	<u>Formation</u>
0 - 60	Surface soil and rock.
60 - 365	Shale.
365 - 397	Shale and shells.
397 - 580	Red beds and shale.
580 - 730	Shale.
730 - 765	ANHYDRITE.
765 - 1490	Shale and shells.
1490 - 1800	Shale and lime.
1800 - 2325	Lime and shale.
2325 - 2785	Shale and lime.
2785 - 3075	Lime and shale.
3075 - 3345	Lime.

RECORDED
STATE REGISTRATION COMMISSION

OCT 28 1958

We hereby certify the above and foregoing to be a true and correct log on the Woydziak #1, located in the NW NW SW, Sec. 6-16s-11w, Barton County, Kansas.

WILKINSON DRILLING, INC.

Walter M. Corbush

Subscribed and sworn to before me this twenty-fourth day of October, nineteen hundred and fifty-eight.

Carolyn J. Moore

My Commission expires January 2, 1961.

PLUGGING
FILE SEC. 6 T. 16 R. 11W
BOOK PAGE 139 LINE 40