

15-009-06 284-0000


STATE OF KANSAS
STATE CORPORATION COMMISSION

Give All Information Completely
Make Required Affidavit
Mail or Deliver Report to:
Conservation Division
State Corporation Commission
211 No. Broadway
Wichita, Kansas

WELL PLUGGING RECORD

Barton County. Sec. 6 Twp. 16 Rge. 11 (W) W (W)
Location as "NE/CNW/SW" or footage from lines C S/2 SW SW
Lease Owner Woodman & Iannitti Drilling Co.
Lease Name Woydziak Well No. 1
Office Address P. O. Box 387, Hoisington, Kansas
Character of Well (completed as Oil, Gas or Dry Hole) Dry Hole
Date well completed December 3, 1956
Application for plugging filed December 3, 1956
Application for plugging approved December 3, 1956
Plugging commenced December 3, 1956
Plugging completed December 3, 1956
Reason for abandonment of well or producing formation Dry

NORTH

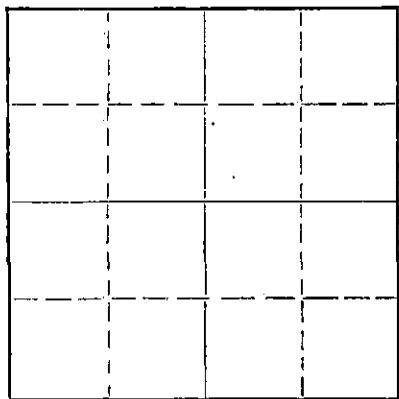

Locate well correctly on above
Section Plat

If a producing well is abandoned, date of last production 19
Was permission obtained from the Conservation Division or its agents before plugging was commenced? Yes

Name of Conservation Agent who supervised plugging of this well R. M. Brundege
Producing formation Arbuckle Depth to top 3314 Bottom Total Depth of Well 3330 Feet
Show depth and thickness of all water, oil and gas formations.

OIL, GAS OR WATER RECORDS

CASING RECORD

FORMATION	CONTENT	FROM	TO	SIZE	PUT IN	PULLED OUT
				8 5/8"	308	

Describe in detail the manner in which the well was plugged, indicating where the mud fluid was placed and the method or methods used in introducing it into the hole. If cement or other plugs were used, state the character of same and depth placed, from feet to feet for each plug set.

B 1/3 sack hulls, then bottom plug at 300' & 20 sacks cement, then heavy mud 1/3 sack hulls and top plug at 35' & 10 sacks cement.

RECEIVED
STATE CORP. COMMISSION
DEC 6 1956
12-6-56
CONSERVATION DIVISION
Wichita, Kansas

(If additional description is necessary, use BACK of this sheet)
Name of Plugging Contractor Woodman & Iannitti Drilling Co.
Address P. O. Box 387, Hoisington, Kansas

STATE OF Kansas, COUNTY OF Sedgwick, ss.
K. T. Woodman (employee of owner) or (owner or operator) of the above-described well, being first duly sworn on oath, says: That I have knowledge of the facts, statements, and matters herein contained and the log of the above-described well as filed and that the same are true and correct. So help me God.

(Signature) K. T. Woodman
717 Union National Building
(Address)

SUBSCRIBED AND SWORN TO before me this 5th day of December, 19 56

My commission expires November 30, 1959
Lucille L. Arrington
Lucille L. Arrington, Notary Public.

PLUGGING
FILE SEC 6 T. 16
BOOK PAGE 122 LINE 43

D R I L L I N G L O G

15-009-06284-0000

Company: Woodman & Iannitti, et al
 Lease: Woydziak
 Well: #1 Woydziak C S/2 SW SW 6-16-11, Barton County, Kansas
 Contractor: Woodman & Iannitti Drilling Co.
 P. O. Box 387, Hoisington, Kansas
 Date Comm: 11-23-56
 Date Compl: 12-3-56
 T. D. 3330'
 Casing: 308 8 5/8" surface casing

Figures Indicate the Bottom of Formation

0-42	S. Soil & Rock	2910	Lime & Shale
60	Shale & Shells	2957	Lime
76	Sand	2995	Shale & Lime Shells
160	Shale & Shells	3060	Shale, Lime & Shells
308	Shale & Shells	3108	Lime
350	Shale & Shells	3150	Lime
400	Shale & Shells	3215	Lime
440	Sand	3280	Lime
465	Iron Pyrite	3320	Lime & Shale
715	Red Bed & Shale	3325	Lime & Shale
745	Iron	3330	Arb.
765	Anhydrite		
770	Anhydrite		
974	Red Bed & Shale		
1095	Shale & Shells		
1335	Shale, Shells & Salt		
1520	Shale & Shells		
1710	Shale & Shells		
1785	Shale & Shells		
1860	Brown Lime & Shale		
1970	Lime & Shale		
2080	Lime & Shale		
2195	Lime & Shale		
2225	Lime & Shale		
2264	Lime & Shale		
2450	Shale & Shells		
2615	Shale & Lime Shells		
2660	Shale & Lime		
2725	Lime		
2810	Shale & Lime		

RECORDED
 STATE CO. 10
 336

CON. 12-6-56

PLUGGING	
FILE NO.	6 T. 16 R. 11W
BOOK	PAGE 122 LINE 43

15-009-06284-0000

GEOLOGICAL TOPS

Elevation	1872	RB
Anhydrite (driller)	765	7 1107
Heebner	2926	-1054
Dodge	2947	-1073
Brown Lime	3018	-1146
Lansing	3034	-1162
Arbuckle	3314	-1442
Total Depth	3330	-1458

I certify the above to be a true and correct copy of the Driller's Log and Geological Tops, to the best of my knowledge and belief.

WOODMAN & LAMBITTI DRILLING CO.

By K. T. Woodman
K. T. WOODMAN