

15-009-21073-0000

STATE OF KANSAS
STATE CORPORATION COMMISSION


WELL PLUGGING RECORD

Give All Information Completely
Make Required Affidavit
Mail or Deliver Report to
Conservation Division
State Corporation Comm.
245 North Water
Wichita, KS 67202

Barton County. Sec. 6 Twp. 16S Rge. 11W
Location as "NE/CNW/SW" or footage from lines
NW SW SE

Lease Owner Icer Addis
Lease Name Kaiser Well No. 1

Office Address P.O. Box 8038, Wichita, Kansas 67208
Character of Well (Completed as Oil, Gas or Dry Hole) Dry Hole

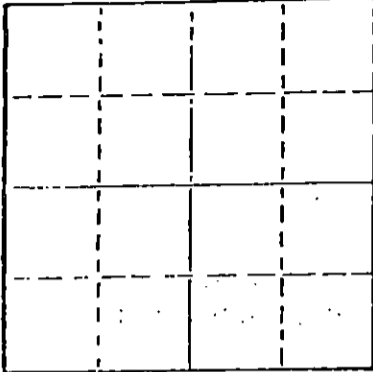

Locate well correctly on above Section Plat

Date Well completed September 18, 1976
Application for plugging filed Verbal Application 1976
Application for plugging approved Verbal Approval 1976
Plugging commenced September 18, 1976
Plugging completed September 18, 1976
Reason for abandonment of well or producing formation _____

If a producing well is abandoned, date of last production 1976

Was permission obtained from the Conservation Division or its agents before plugging was commenced? Yes

Name of Conservation Agent who supervised plugging of this well Duane Rankin
Producing formation _____ Depth to top _____ Bottom _____ Total Depth of Well 3,350'
Show depth and thickness of all water, oil and gas formations.

OIL, GAS OR WATER RECORDS				CASING RECORD		
FORMATION	CONTENT	FROM	TO	SIZE	PUT IN	PULLED OUT
				8-5/8"	259'	None

Describe in detail the manner in which the well was plugged, indicating where the mud fluid was placed and the method or methods used in introducing it into the hold. If cement or other plugs were used, state the character of same and depth placed, from _____ feet to _____ feet for each plug set.

Filled hole with heavy rotary mud from 3,350 ft. (rotary total depth) to 450 ft. Set plug at 450 ft. and cemented with 40 sacks cement. Filled hole with heavy rotary mud from 450 ft. to 260 ft. Set plug at 260 ft. and cemented with 20 sacks cement. Filled hole with heavy rotary mud from 260 ft. to 40 ft. Set solid plug at 40 ft. and cemented to cellar with 10 sacks cement, 2 sacks cement in rat hole.

Plugging operations accomplished utilizing Halliburton Oil Well cementing pump truck through 4-1/2 inch drill pipe.

(If additional description is necessary, use BACK of this sheet)
Name of Plugging Contractor Halliburton Services
410 Union Center Bldg., Wichita, Kansas 67202


STATE OF Kansas COUNTY OF Sedgwick
Dean Britting, Agent (Notary Public) of the above-described

Dean Britting has duly sworn on oath, says: That I have knowledge of the facts, statements, and matters herein contained and the log of the above-described well as filed and that the same are true and correct. So help me God.

(Signature) Dean Britting
200 No. Main, Wichita, Kansas 67202
(Address)

SUBSCRIBED AND SWORN TO before me this 24th day of September, 19 76

My commission expires June 30, 1978
Elsie Willison - Notary Public

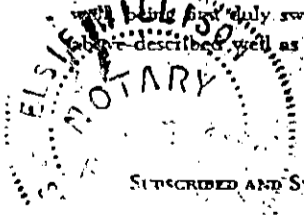

KANSAS GEOLOGICAL SOCIETY API NO. - 15-009-21,073
-000


KANSAS WELL LOG BUREAU - KANSAS WELL SAMPLE BUREAU
KANSAS GEOLOGICAL SOCIETY BUILDING
508 EAST MURDOCK - WICHITA, KANSAS

COMPANY Icer Addis
FARM Kaiser NO. 1

SEC. 6 T. 16S R. 11W
LOC. NW SW SE

TOTAL DEPTH 3,350'
COMM. September 10, 1976 COMP. September 18, 1976
SHOT OR TREATED
CONTRACTOR H-30, Inc.
ISSUED September 24, 1976

COUNTY Barton
KANSAS

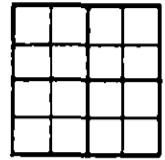

CASING
20 10
15 8 -5/8" 295' cemented w/175 sxs cement ELEVATION 1,828 KB
12 6
13 5

PRODUCTION

FIGURES INDICATE BOTTOM OF FORMATIONS

Post Rock	50'
Shale and Shells	68'
Shale and Sand	259'
Red Bed and Hard Sand	408'
Shale and Sand	711'
Shale and Shells	1,135'
Shale and Lime	1,565'
Lime and Shale	1,900'
Shale	2,717'
Shale and Lime	2,795'
Lime	3,350'
Rotary Total Depth	3,350'


SEP 24 1976
COURTESY OF H-30, INC.
WICHITA, KANSAS

I hereby certify the above and foregoing to be a true and correct log of the above described well as shown by the drilling reports.

H-30, INC.

Jean Britting
Jean Britting

State of Kansas }
County of Sedgwick } ss:

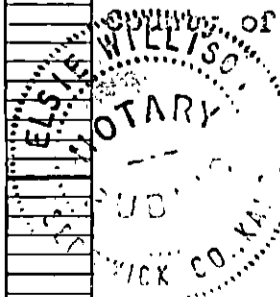

Subscribed and Sworn to before me a Notary Public in and for said county and state this 24th. day of September, 1976.

Elsie Willison
Elsie Willison-Notary Public

My Commission Expires:
June 30, 1978