


Give All Information Completely  
Make Required Affidavit  
Mail or Deliver Report to:  
Conservation Division  
State Corporation Commission  
800 Bittling Building  
Wichita, Kansas

WELL PLUGGING RECORD

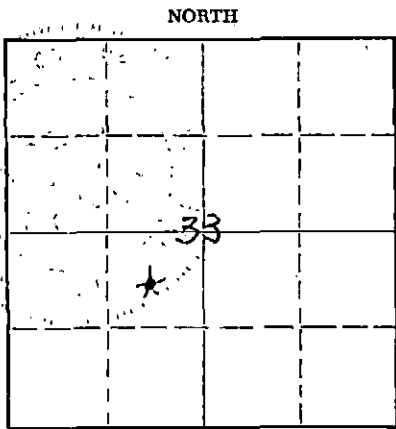

Locate well correctly on above  
Section Plat

KEARNEY County. Sec. 33 Twp. 24S Rge. (E) 35 (W)  
Location as "NE/CNW/SW" or footage from lines C NE SW  
Lease Owner MALLONEE-MAHONEY, INC.  
Lease Name CARSON Well No. 1  
Office Address BOX 1257 LIBERAL, KANSAS  
Character of Well (completed as Oil, Gas or Dry Hole) DRY HOLE  
Date well completed \_\_\_\_\_ 19\_\_\_\_  
Application for plugging filed JAN. 28 19 74  
Application for plugging approved JAN. 29 19 74  
Plugging commenced MAR. 19 19 74  
Plugging completed MAR. 19 19 74  
Reason for abandonment of well or producing formation \_\_\_\_\_

If a producing well is abandoned, date of last production \_\_\_\_\_ 19\_\_\_\_  
Was permission obtained from the Conservation Division or its agents before plugging was commenced? YES

Name of Conservation Agent who supervised plugging of this well EDGAR EVES  
Producing formation \_\_\_\_\_ Depth to top \_\_\_\_\_ Bottom \_\_\_\_\_ Total Depth of Well 4998' Feet  
Show depth and thickness of all water, oil and gas formations.

OIL, GAS OR WATER RECORDS

CASING RECORD

FORMATION	CONTENT	FROM	TO	SIZE	PUT IN	PULLED OUT

Describe in detail the manner in which the well was plugged, indicating where the mud fluid was placed and the method or methods used in introducing it into the hole. If cement or other plugs were used, state the character of same and depth placed, from \_\_\_\_\_ feet to \_\_\_\_\_ feet for each plug set.

3059' TO 3054' >  
3049' TO 3041' > 20 SX COMMON  
655 TO 555 35 SX COMMON  
45 TO 0 15 SX COMMON

RECEIVED  
STATE CORPORATION COMMISSION  
MAR 21 1974  
CONSERVATION DIVISION  
Wichita, Kansas

(If additional description is necessary, use BACK of this sheet)


Name of Plugging Contractor SARGENTS CASING PULLING SERVICE  
Address LIBERAL, KANSAS 67901

STATE OF KANSAS, COUNTY OF SEWARD, ss.  
B. A. CLIFFT (employee of owner) or (owner or operator) of the above-described

well, being first duly sworn on oath, says: That I have knowledge of the facts, statements, and matters herein contained and the log of the above-described well as filed and that the same are true and correct. So help me God.

(Signature) *B. A. Cliff*  
Box 1257, LIBERAL, KANSAS 67901  
(Address)

SUBSCRIBED AND SWORN TO before me this 19th day of MARCH, 1974

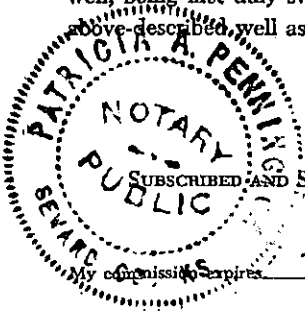

*Patricia A. Pennington*  
PATRICIA A. PENNINGTON Notary Public.



GABBERT-JONES, INC.  
WICHITA, KANSAS  
DRILLERS' WELL LOG

RECEIVED  
STATE CORPORATION COMMISSION  
FEB 7 1974  
CONSERVATION DIVISION  
Wichita, Kansas

~~CARSON~~ UNREIN-CARSON #1  
C NE SW, Section 33-24S-35W  
Kearny County, Kansas

Commenced: July 13, 1973  
Completed: July 25, 1973

OPERATOR: MALLONEE-MAHONEY

Depth From	To	Formation	Remarks
0	290	Shale-sand	Ran 15 jts of new 20# 8 5/8" csg. set @ 661' cemented w/300 sks
290	355	Shale	
355	662	Sand-shale	Howcolite w/150 sks common, 3% CC
662	755	Shale	P.D. @ 11:15 PM 7/13/73
755	1650	Redbed & sand	Cement Circ.
1650	1831	Shale-shells	
1831	1846	Lime	
1846	2065	Redrock & shale	
2065	2315	Shale-lime	
2315	3315	Lime-shale	
3315	4609	Lime	
4609	4675	Lime-shale	
4675	4760	Shale	
4760	4998	Lime	Ran 104 jts of new 9 1/2# 4 1/2" csg. set @ 3350' cemented w/150 sks litewt 200 sks 50/50 Posmix 12 1/2# Gilsonite P.D. 7 PM 7/25/1973
4998	TD		

I, James S. Sutton, II, certify this is a correct copy of the Drillers' Log for the well drilled in the C NE SW, Sec. 33-24S-35W, Kearny County, Kansas to the best of my knowledge and belief.

*James S. Sutton*  
James S. Sutton, II

STATE OF KANSAS )  
) SS  
COUNTY OF SEDGWICK )

Before me, the undersigned, a Notary Public within and for said County and State, on this 30th day of July, 1973, personally appeared James S. Sutton, II, to me personally known to be the identical person who executed the within and foregoing instrument and acknowledged to me that he executed the same as his free and voluntary act and deed for the uses and purposes therein set forth.

IN WITNESS WHEREOF, I have hereunto set my hand and official seal the day and year last above written.

*Marjorie Hall*  
Marjorie Hall, Notary Public

