

15-009-21255-0000

WELL PLUGGING RECORD

Give All Information Completely
 Make Required Affidavit

COUNTY Barton SEC. 8 TWP. 16 RGE. 11 ~~11~~ 11
 Location as in quarters or footage from lines:
SE/SW/NE NE 1/4 8-17-2014

Locate Well
 correctly on above
 Section Platt.

Lease Owner The Roxana Corporation
 Lease Name O'Leary "B" Well No. #2
 Office Address Box 1162 - Great Bend, Kansas 67530
 Character of Well (Completed as Oil, Gas or Dry Hole): Oil
 Date Well Completed _____
 Application for plugging filed _____
 Plugging commenced July 10, 1982
 Plugging completed July 16, 1982
 Reason for abandonment of well or producing formation Depleted

Was permission obtained from the Conservation Division or it's
 Agent's before plugging was commenced? Yes

Name of Conservation Agent who supervised plugging of this well J. Metz

Producing formation _____ Depth to top _____ bottom _____ T.D. 3328 1/2'

Show depth and thickness of all water, oil and gas formations.

OIL, GAS OR WATER RECORDS

Casing Record

Formation	Content	From	To	Size	Put in	Pulled Out
				8 5/8"	297'	NONE
				4 1/2"	3301'	2560.49'

Describe in detail the manner in which the well was plugged, indicating where the mud
 fluid was placed and the method or methods used in introducing it into the hold. If cement
 or other plugs were used, state the character of same and depth placed, from _____ feet
 to _____ feet for each plug set.

Dumped sand to 2950' and four (4) sacks cement.
Shot pipe @ 2740' and 2590'.
Pulled seventy-four (74) joints 4 1/2" casing.
Squeezed well with four (4) sacks hulls, twenty-five (25)
sacks cement, twenty-five sacks gel, one (1) sack hulls, released
plug and mixed one hundred twenty-five (125) sacks 50/50 pozmix
cement with 4% added gel and 3% calcium chloride.

(If additional description is necessary, use BACK of this sheet)

Name of Plugging Contractor Rockhold Engineering, Inc.

STATE OF KANSAS COUNTY OF BARTON, ss.

James W. Rockhold (employee of owner) or (owner or operator) of the
 above-described well, being first duly sworn on oath, says: That I have knowledge of the
 facts, statements, and matters herein contained and the log of the above-described well as
 filed and that the same are true and correct. So help me God


(Signature) James W. Rockhold
 JAMES W. ROCKHOLD - Box 698 - Great Bend,
 (Address) Kansas 67530

SUBSCRIBED AND SWORN TO before me this 12 day of August, 1982

Margaret Prosser
 Notary Public.

My Commission expires: _____

RECEIVED
 STATE CORPORATION COMMISSION

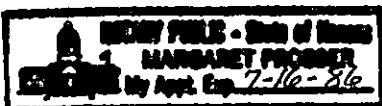

AUG 13 1982
 8-13-82
 CONSERVATION DIVISION
 Wichita, Kansas

KANSAS DRILLERS LOG

API No. 15 — 009 — 21,255-0000
 County Number

S. 8 T. 16 R. 11 ^EW

Loc. SE SW NE

County Barton

Operator
The Roxana Corporation

Address
Box 1162 Great Bend, Kansas 67530

Well No. #2B Lease Name O'Leary


Footage Location
330 feet from (S) line 990 feet from (W) line NE/4

Principal Contractor Woodman - Iannitti Geologist Jim Musgrove

Spud Date 11-19-77 Total Depth 3304 P.B.T.D. -

Date Completed 12-14-77 Oil Purchaser Phillips Petroleum Co.

640 Acres
 N

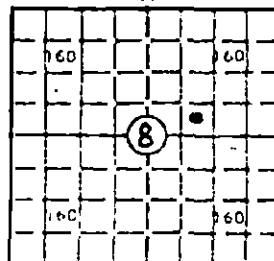

Elev.: Gr. 1837

DF 1839 KB 1842

CASING RECORD

Report of all strings set — surface, intermediate, production, etc.

Purpose of string	Size hole drilled	Size casing set (in O.D.)	Weight lbs/ft.	Setting depth	Type cement	Sacks	Type and percent additives
Surface	12 1/4	8 5/8"	28#	297	Common	175	3% cc 2% Gel
Production	7 7/8	4 1/2"	10.5#	3301	Poz <u>CO/20</u>	150	Salt Sat.

LINER RECORD

PERFORATION RECORD

Top, ft.	Bottom, ft.	Sacks cement	Shots per ft.	Size & type	Depth interval

TUBING RECORD

Size	Setting depth	Packer set at			
2 3/8" EUE	3301'				

ACID, FRACTURE, SHOT, CEMENT SQUEEZE RECORD

Amount and kind of material used	Depth interval treated

INITIAL PRODUCTION

Date of first production December 1977 Producing method (flowing, pumping, gas lift, etc.) Pumping

RATE OF PRODUCTION PER 24 HOURS
 Oil 60 bbls. Gas - MCF Water - bbls. Gas-oil ratio - CFPB

Disposition of gas (vented, used on lease or sold) - - Producing interval(s) Arbuckle

INSTRUCTIONS: As provided in KCC Rule 82-2-125, within 90 days after completion of a well, one completed copy of this Drillers Log shall be transmitted to the State Geological Survey of Kansas, 4150 Monroe Street, Wichita, Kansas 67209. Copies of this form are available from the Conservation Division, State Corporation Commission, 3830 So. Meridian (P.O. Box 17027), Wichita, Kansas 66217. Phone AC 316-522-2206. If confidential custody is desired, please note Rule 82-2-125. Drillers Logs will be on open file in the Oil and Gas Division, State Geological Survey of Kansas, Lawrence, Kansas 66044.

RECEIVED
 STATE CORPORATION COMMISSION
 JUL 12 1982
 CONSERVATION DIVISION
 Wichita, Kansas

DESIGNATE TYPE OF COMP.: OIL, GAS,
DRY HOLE, SWDW, ETC.:

Oil

The Roxana Corporation

Well No.

B-2

Lease Name

O'Leary

S 8 T 16 R 11 W

Barton County, Kansas

WELL LOG

Show all important zones of porosity and contents thereof; cored intervals, and all drill-stem tests, including depth interval tested, cushion used, time tool open, flowing and shut-in pressures, and recoveries.

SHOW GEOLOGICAL MARKERS, LOGS RUN, OR OTHER DESCRIPTIVE INFORMATION.

Sample

FORMATION DESCRIPTION, CONTENTS, ETC.	TOP	BOTTOM	NAME	DEPTH
DST #1 2810-2833 30-30-30-30 Weak blow			Anhydrite	712 (+1133)
50' Oil specked mud			Heebner	2883 (-1041)
SIP 372-274#			Toronto	2901 (-1059)
FP 76-76#			Brown Lime	2977 (-1135)
DST #2 3081-3090 30-30-30-30 Fair blow			Lansing	2992 (-1150)
Recovery 2' oil			Base K.C.	3263 (-1420)
118' oil specked water			Conglomerate	3285 (-1443)
SIP 711-701#			Arbuckle	3299 (-1457)
FP 33-85#			R.T.D.	3304 (-1462)
DST #3 3284-3304 45-45-45-45 Strong blow				
720' gassy oil				
240' muddy oil				
SIP 1051-1041#				
IFP 72-248#				
FFP 283-400#				

RECEIVED
STATE CORPORATION COMMISSION
JUL 12 1982
CONSERVATION DIVISION
Wichita, Kansas

USE ADDITIONAL SHEETS, IF NECESSARY, TO COMPLETE WELL RECORD.

Date Received

J. C. Musgrove
Signature
President
Title
January 27, 1978
Date

Sun Oilwell Cementing
A Division of BJ Hughes, Inc.

P. O. Box 169
GREAT BEND, KANSAS 67530

15-009-21255-0000
CEMENTING TICKET No. 12530
and Invoice Number

Date	Customer Order No.	Sec.	Twp.	Range	Truck Called Out	On Location	Job Began	Job Completed
7-16-82		8	16	11	7:00 AM	9:30 AM	10:00 AM	
Owner		Contractor			Charge To			
Roxava Co.					Roxava Co.			
Mailing Address		City			State			
Well No. and Farm		Place		County		State		
O'Leary B-2		Hitchman 1st Section E		Barton		Kansas		
Depth of Well	Depth of Job	Casing { New } { Used }	Size	Size of Hole Amt. and Kind of Cement	Cement Left in casing by }	Request Necessity		
			Weight	8 5/8 150				
Kind of Job				OW	Drillpipe	{ Rotary } { Cable }	Truck No.	
Plug to Abandon				NW	Tubing		#30	
Condition of Well at time of Cementing		D. on A.			Typ of Plugs			
					Wooden			

Pressure Circulating _____ Minimum _____ Maximum _____

Time Required Mixing Cement _____ min. Making Change _____ min. Pumping Cement _____ min.

Remarks: mixed 4 Hulls, 25sk 5% Po₂, 4% Gel, 3% Cacl, 25sk gel + 1 Hulls! Released plug + mixed 125sk 5% Po₂, 4% Gel, 3% Cacl. Had shot in head when shot in.

Price Reference No.	9
Price of Job	370.00
Second Stage	
Standby Truck	
Other Charges	
Pump Truck Mileage	51.00

Thanks

Cementer Bob Baker Material Left on Location 8 5/8 Plug Container

Helper Tim D. District Great Bend State Kansas

The above job was done under supervision of the owner, operator, or his agent whose signature appears below.

[Signature] Agent of Contractor or Operator

Prices Subject to Correction.

SALES TICKET FOR MATERIALS

QUANTITY SACKS	BRAND AND TYPE	PRICE	TOTAL
75	Common		
75	Po ₂		
500 th	Hulls		
Cc Cl.	378#		
AM. Cl.			
Gel	3004 II		
Plugs	1 8 5/8 Wooden (Dry Hole)		
Delivered by Truck No. <u>B-25</u>		Handling and Dumping	<p>RECEIVED STATE CORPORATION COMMISSION JUL 21 1982 CONSERVATION DIVISION Wichita, Kansas</p>
Delivered From <u>Great Bend</u>		Mileage <u>34</u>	
Signature of Operator <u>Randy S.</u>		Sales Tax	
		Total Charges	

CUSTOMER COPY

15-009-21255-0000

NICKELSON LUMBER CO., INC.

Phone 793-3541

3413 West 10th St.

P. O. Box 996

GREAT BEND, KANSAS 67530

Customer's Order No. O'LEARY "B"-#2 Date 7/12 1982

M KOXANNA CORPORATION

Address Box 1162 Gt. Bend

Quan.	Description	Feet	Total FT.	Price	Amount
1	4 sks Portland Cement				
2					
3					
4					
5					
6					
7					
8					
9					
10					
11					
12					

RECEIVED
STATE CORPORATION COMMISSION
JUL 21 1982
CONSERVATION DIVISION
Topeka, Kansas

Handwritten signature

OUR TERMS
ALL CREDIT SALES ARE DUE AND PAYABLE AS EITHER 30 DAY ACCOUNTS OR 3-PAY ACCOUNTS BY AGREEMENT, UNLESS SPECIFIC ARRANGEMENTS FOR CONSUMER CREDIT ARE MADE FOR EXTENDED TERMS THROUGH INSTALLMENT CREDIT.

All Claims and Returned Goods MUST be Accompanied by This Bill.

No. 58299

Driver _____

Received by R.P. Palley