


15009-21409-0000

STATE OF KANSAS
STATE CORPORATION COMMISSION

WELL PLUGGING RECORD

Give All Information Completely.
Make Required Affidavit
Mail or Deliver Report to
Conservation Division
State Corporation Comm.
245 North Water
Wichita, KS 67202

Barton County. Sec. 8 Twp. 16 Rge. 11 E/W
Location as "NE/CNW $\frac{1}{4}$ SW $\frac{1}{4}$ " or footage from lines _____
SW NE SE
Lease Owner The Roxana Corporation
Lease Name Wirth Well No. 2
Office Address P. O. Box 1162, Great Bend, Kansas 67530
Character of Well (Completed as Oil, Gas or Dry Hole) _____

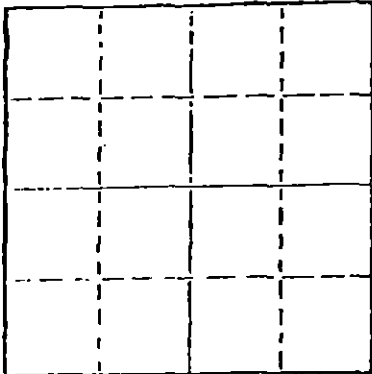

Locate well correctly on above
Section Plat

dry hole
Date Well completed Sept. 7 19 78
Application for plugging filed Sept. 7 19 78
Application for plugging approved Sept. 7 19 78
Plugging commenced Sept. 7 19 78
Plugging completed Sept. 7 19 78
Reason for abandonment of well or producing formation _____

dry hole
If a producing well is abandoned, date of last production _____ 19 _____

Was permission obtained from the Conservation Division or its agents before plugging was commenced? yes

Name of Conservation Agent who supervised plugging of this well Duane L. Rankin
Producing formation _____ Depth to top _____ Bottom _____ Total Depth of Well 3400
Show depth and thickness of all water, oil and gas formations.

OIL, GAS OR WATER RECORDS

CASING RECORD

FORMATION	CONTENT	FROM	TO	SIZE	PUT IN	PULLED OUT
				8 5/8	354	

Describe in detail the manner in which the well was plugged, indicating where the mud fluid was placed and the method or methods used in introducing it into the hold. If cement or other plugs were used, state the character of same and depth placed, from _____ feet to _____ feet for each plug set.

1st plug 400' w/60 sx.
2nd plug 40' w/10 sx.
rat hole 2 sx.

(If additional description is necessary, use BACK of this sheet)

Name of Plugging Contractor Woodman & Iannitti Drilling Co.

STATE OF KANSAS COUNTY OF SEDGWICK, ss.
K. T. Woodman (employee of owner) or (owner or operator)
of the above-described well, being first duly sworn on oath, says: That I have knowledge of the facts, statements, and matters herein contained and the log of the above-described well as filed and that the same are true and correct. So help me God.

(Signature) K. T. Woodman
1008 Douglas Bldg. 104 So. Broadway
(Address)

SUBSCRIBED AND SWORN TO before me this 13th day of September, 19 78

My commission expires Feb. 11, 1980

Justina Chamberlain
Notary Public.

RECEIVED
STATE CORPORATION COMMISSION

SEP 14 1978
9-14-78
CONSERVATION DIVISION
Wichita, Kansas

K. T. WOODMAN
RES. PHONE 733-0418
OFF. PHONE 265-7650
WICHITA, KANSAS

D. J. IANNITTI
PHONE 792-2921
GREAT BEND, KANSAS

WOODMAN & IANNITTI DRILLING COMPANY
Rotary Drilling Contractors

15009-21409-0000

1008 DOUGLAS BUILDING
104 S. BROADWAY
WICHITA, KANSAS 67202

September 13, 1978

Company;	The Roxana Corporation
Farm;	#2 Wirth
Location;	SW NE SE
Section;	8-16-11W
County;	Barton
Contractor;	Woodman & Iannitti Drilling Co.
Comm;	August 30, 1978
Compl;	September 7, 1978
Total Depth;	3400'
Casing;	8 5/8 @ 354 w/175 sx.
Production;	D & A

Figures Indicate Bottom Of Formations:

74	Post rock
90	Shale w/streaks post rock
356	Shale & sand streaks
632	Shale & redbed
708	Redbed
733	Anhy
1385	Shale
1755	Shale & lime
2020	Lime & shale
2160	Lime & shale
2627	Lime & shale
2990	Lime & shale
3040	Lime
3049	Lime & shale
3254	Lime
3329	Lime & shale
3400	Lime

I certify the above to be a true and correct copy of the driller's log to the best of my knowledge and belief.

Woodman & Iannitti Drilling Co.

K. T. Woodman
K. T. Woodman

RECEIVED
STATE CORPORATION COMMISSION

SEP 14 1978

CONSERVATION DIVISION
Wichita, Kansas