


STATE OF KANSAS
STATE CORPORATION COMMISSION

Give All Information Completely
No Required Affidavit
File or Deliver Report to:
Conservation Division
State Corporation Commission
211 No. Broadway
Wichita, Kansas

WELL PLUGGING RECORD

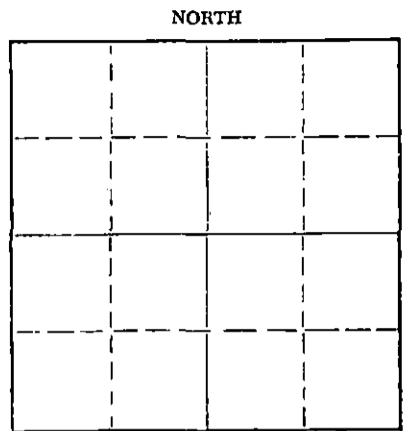

Locate well correctly on above Section Plat

Barton County. Sec 9 Twp. 16S Rge. 11W (EX) (W)
Location as "NE/CNW/SW" or footage from lines SE SE SW
Lease Owner Herman George Kaiser, Oil Producer
Lease Name Davidson Well No. 1
Office Address 909 Palace Building, Tulsa, Oklahoma
Character of Well (completed as Oil, Gas or Dry Hole) Dry Hole
Date well completed 4-28-63 19
Application for plugging filed 4-28-63 19
Application for plugging approved 4-28-63 19
Plugging commenced 4-28-63 19
Plugging completed 4-28-63 19
Reason for abandonment of well or producing formation Dry Hole

If a producing well is abandoned, date of last production _____ 19____
Was permission obtained from the Conservation Division or its agents before plugging was commenced? yes

Name of Conservation Agent who supervised plugging of this well Donald Truan, Russell, Kansas
Producing formation _____ Depth to top _____ Bottom _____ Total Depth of Well 3325' Feet
Show depth and thickness of all water, oil and gas formations.

OIL, GAS OR WATER RECORDS

CASING RECORD

FORMATION	CONTENT	FROM	TO	SIZE	PUT IN	PULLED OUT
				8 5/8"	305'	none

Describe in detail the manner in which the well was plugged, indicating where the mud fluid was placed and the method or methods used in introducing it into the hole. If cement or other plugs were used, state the character of same and depth placed, from _____ feet to _____ feet for each plug set.

Mud to 240' Plug with 1/2 sack hulls and 25 sacks cement
Mud to 35' Plug with 1/2 sk. hulls and 10 sacks cement to base of cellar.

RECEIVED
STATE CORPORATION COMMISSION
APR 30 1963
4-30-63
CONSERVATION DIVISION
WICHITA, KANSAS

(If additional description is necessary, use BACK of this sheet)
Name of Plugging Contractor Leben Drilling, Inc.
Address P. O. Box 486, Great Bend, Kansas

STATE OF KANSAS, COUNTY OF BARTON, ss.
Leslie Kite (employee of owner) or (owner or operator) of the above-described well, being first duly sworn on oath, says: That I have knowledge of the facts, statements, and matters herein contained and the log of the above-described well as filed and that the same are true and correct. So help me God.

(Signature) Leslie Kite
P. O. Box 486, Great Bend, Kansas
(Address)

SUBSCRIBED AND SWORN TO before me this 29th day of April, 1963.

My commission expires April 1, 1967
Ulanda Nichols Notary Public

INVOICED
DATE 4/30/63
INV. NO. 6999-w

DRILLER'S LOG

COMPANY: Herman George Kaiser
Oil Producer
CONTRACTOR: LEBEN DRILLING, INC.
FARM: DAVIDSON #1'
LOCATION: SE SE SW of Section 9-16S-11W
BARTON COUNTY, KANSAS
COMMENCED: 4-20-63
COMPLETED: 4-27-63

0	80	Post Rock, Clay
80	305	Shale, Sand, Shale, Shells
305	550	Shale, Pyrite, Redbed
550	702	Redbed
702	737	Anhydrite
737	1175	Redbed, Shale, Shells
1175	1445	Shale, Shells
1445	2005	Lime, Shale
2005	2225	Shale, Lime
2225	3057	Lime, Shale
3057	3325	Lime
	<u>3325</u>	<u>Rotary Total Depth - D. & A.</u>

Set 8 5/8" used surface casing @ 305' Cemented with 175 sks. Quick-Set, GL 3 by Globe.

I, Leslie Kite, do hereby certify that the above and foregoing is a true and correct copy of the log of the Davidson #1, located SE SE SW of Section 9, Township 16 South, Range 11 West, Barton County, Kansas, as reflected by the files of Leben Drilling, Inc.

Leslie Kite

Leslie Kite

STATE OF KANSAS)
) SS
COUNTY OF BARTON)

Subscribed and sworn to before me, a Notary Public, in and for Barton County, Kansas, this 29th day of April, 1963.

Ulanda Nichols

Ulanda Nichols

My Commission Expires:
April 1, 1967

RECEIVED
STATE CORPORATION COMMISSION

APR 30 1963

CONSERVATION DIVISION
Wichita, Kansas