

OR


~~FORMATION PLUGGING RECORD~~

Strike out upper line when reporting plugging off formations.

15-009-15162-0000

Give All Information Completely  
Make Required Affidavit  
Mail or Deliver Report to:  
Conservation Division  
State Corporation Commission,  
800 Bitting Building,  
Wichita, Kansas

NORTH

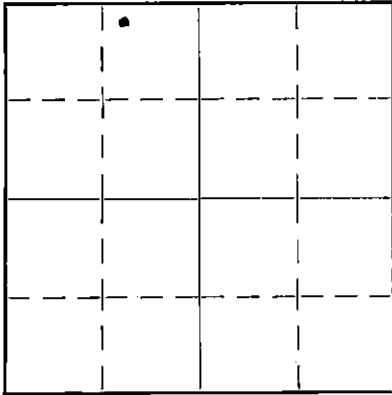

Locate well correctly on above Section Plat

Barton County, Sec. 9 Twp. 16S Rge. (E) 11 (W)

Location as "NE 1/4 NW 1/4 SW 1/4" or footage from lines NW/4

Lease Owner Sinclair Prairie Oil Co

Lease Name Anna B. Davidson "A" Well No. 1

Office Address Box 521, Tulsa, Okla.

Character of Well (Completed as Oil, Gas or Dry Hole) Dry hole

Date, well completed May 23 1937

Application for plugging filed May 31 1937

Application for plugging approved June 2 1937

Plugging Commenced May 31 1937

Plugging Completed May 31 1937

Reason for abandonment of well or producing formation Dry hole

If a producing well is abandoned, date of last production --- 1937

Was permission obtained from the Conservation Division or its agents before plugging was commenced? Yes, by telephone

Name of Conservation Agent who supervised plugging of this well C.T. Alexander

Producing formation None Depth to top --- Bottom --- Total Depth of Well 3359 Feet

Show depth and thickness of all water, oil and gas formations.

OIL, GAS OR WATER RECORDS

CASING RECORD

Formation	Content	Top Base		Size	Put In	Pulled Out
		From	To			
Kansas City	water	2980	3280	16"	240'	none
Conglomerate		3280	3344	(cemented in w/240 sax cmt)		
Arbuckle	water	3344	3359	(when run in well.)		

Describe in detail the manner in which the well was plugged, indicating where the mud fluid was placed and the method or methods used in introducing it into the hole. If cement or other plugs were used, state the character of same and depth placed, from --- feet to --- feet for each plug set.

3359' - 240' mudded w/rotary mud bridged  
240' - 220' cemented w/ 20 sax cmt  
220' - 40' mudded w/ rotary mud bridged  
40' - to bottom of cellar cemented w/40 sax cmt.

PLUGGING  
FILE SEC 9-T6-R-110  
BOOK PAGE 72 LINE 23

(If additional description is necessary use BACK of this sheet)

Correspondence regarding this well should be addressed to Mr. O.E. Randolph  
Address Box 650, McPherson, Kas.

STATE OF Kansas, COUNTY OF C. McPherson, ss.  
I. O.E. Randolph (employee of owner) or (owner or operator) of the above-described well,

being first duly sworn on oath, says: That I have knowledge of the facts, statements, and matters herein contained and the log of the above-described well as filed and that the same are true and correct. So help me God.

(Signature) O.E. Randolph

McPherson Kan (Address)

SUBSCRIBED AND SWORN to before me this 12th day of June 1937

My commission expires 2/4/39 Notary Public.

15009-15142-0000

SINCLAIR PRAIRIE OIL COMPANY

Anna B. Davidson #1 "A"

382' fm Nth & 1650' fm West lines

NW/4 Sec 9 Twp 16S Range 11W Barton Co. Kas.

Rotary hole.

Lime	0	50'
Shale, Lime Shells		155
Shale, Shells		165
Shale, Lime Shells		450
Red Bed		522
Red Bed & Shale		676
Lime		710
Shale & Shells		802
Red Bed		875
Shale, Shells		990
Shale & Lime Shells		1266
Salt		1340
Lime, broken		1360
Lime		1450
Lime, hard		1510
Shale		1518
Lime		1678
Lime, broken		1763
Lime		1923
Lime, hard		1997
Lime		2057
Lime, broken		2105
Shale		2117
Lime, broken		2168
Lime		2225
Shale & Shells		2288
Shale, Lime		2380
Shale & Shells		2587
Lime		2897
Lime, broken		2995
Lime, K.C. Top 2980'		3013
Lime		3067
Lime, broken		3117
Lime, K.C.		3145
Lime, K.C. hard		3197
Lime		3225
Shale, sticky		3242
Lime, KC		3286
Conglomerate Top 3280'		3344
Arbuckle Lime Top 3344'		3359' TD

dry hole

PLUGGING  
 FILE SEC 9 16 R 11 W  
 BOOK PAGE 92 LINE 23