


Give All Information Completely  
Make Required Affidavit  
Mail or Deliver Report to:  
Conservation Division  
State Corporation Commission  
212 No. Market  
Wichita, Kansas

WELL PLUGGING RECORD

95-009-20144-0500

NORTH

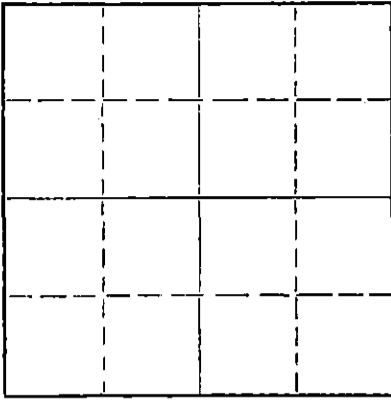

Locate well correctly on above Section Plat

Barton County. Sec. 9 Twp. 16S Rge. 11W (~~EX~~) (W)  
Location as "NE/CNW/SW" or footage from lines NE SE NE  
Lease Owner Herman Geo. Kaiser, Oil Producer  
Lease Name Davidson Well No. C-#2  
Office Address 909 Palace Bldg., Tulsa, 74103  
Character of Well (completed as Oil, Gas or Dry Hole) Dry Hole  
Date well completed 11-16-67 19\_\_  
Application for plugging filed 11-16-67 19\_\_  
Application for plugging approved 11-16-67 19\_\_  
Plugging commenced 11-16-67 19\_\_  
Plugging completed 11-16-67 19\_\_  
Reason for abandonment of well or producing formation Dry Hole

If a producing well is abandoned, date of last production 19\_\_  
Was permission obtained from the Conservation Division or its agents before plugging was commenced? yes

Name of Conservation Agent who supervised plugging of this well Donald Truan  
Producing formation \_\_\_\_\_ Depth to top \_\_\_\_\_ Bottom \_\_\_\_\_ Total Depth of Well 3324 Feet  
Show depth and thickness of all water, oil and gas formations.

OIL, GAS OR WATER RECORDS

CASING RECORD

FORMATION	CONTENT	FROM	TO	SIZE	PUT IN	PULLED OUT
				8 5/8"	296'	none

Describe in detail the manner in which the well was plugged, indicating where the mud fluid was placed and the method or methods used in introducing it into the hole. If cement or other plugs were used, state the character of same and depth placed, from \_\_\_\_\_ feet to \_\_\_\_\_ feet for each plug set.

Spotted 65 sks. 50/50 Posmix @ 450' through drill pipe  
Spotted 25 sks. 50/50 Posmix @ 280; through drill pipe  
Bridged @ 40' 10 sks. cement

NOV 21 1967  
11-21-67  
Conservation Division  
Wichita, Kansas

(If additional description is necessary, use BACK of this sheet)

Name of Plugging Contractor Leben Drilling, Inc.  
Address Box 486, Great Bend, Kansas 67530

STATE OF KANSAS, COUNTY OF BARTON, ss.  
Leslie Kite (employee of owner) or (owner or operator) of the above-described well, being first duly sworn on oath, says: That I have knowledge of the facts, statements, and matters herein contained and the log of the above-described well as filed and that the same are true and correct. So help me God.

(Signature) Leslie Kite

Box 486, Great Bend, Kansas 67530  
(Address)

SUBSCRIBED AND SWORN TO before me this 20th day of November, 19 67

My commission expires April 1, 1971

Ulanda Nichols  
Notary Public.

15009-20144-0000

DRILLER'S LOG

COMPANY: Herman Geo. Kaiser  
Oil Producer  
CONTRACTOR: LEBEN DRILLING, INC.  
FARM: DAVIDSON C-#2  
LOCATION: NE SE NE SECTION 9-16S-11W  
BARTON COUNTY, KANSAS  
COMMENCED: 11-10-67  
COMPLETED: 11-16-67

-----

0	101	Post Rock
101	183	Shale & Sand
183	296	Shale & Sand
296	812	Sand
812	1400	Shale, Sand
1400	1805	Lime, Shale
1805	2034	Lime
2034	2702	Shale
2702	2935	Lime
2935	2995	Shale, Lime
2995	3095	Lime
3095	3130	Sandy Lime
3130	3293	Lime
3293	3324	Conglomerate
	<u>3324</u>	<u>RTD - D. &amp; A.</u>

RECEIVED  
STATE COMMISSIONER OF GEOL. & MINES  
NOV 21 1967  
CONSERVATION DIVISION  
Topeka, Kansas

-----

8 5/8" 28# used surface casing set @ 296' cemented with 225 sacks of Common, 2% cc

-----

I, Leslie Kite, do hereby certify that the above and foregoing is a true and correct copy of the log of the Davidson C-#2 Well, located NE SE NE of Section 9, Township 16 South, Range 11 West, Barton County, Kansas, as reflected by the records of Leben Drilling, Inc.

Leslie Kite  
Leslie Kite

STATE OF KANSAS )  
) SS  
COUNTY OF BARTON )

Subscribed and sworn to and before me, a Notary Public, in and for Barton County, Kansas, this 20th day of November, 1967.

Ulanda Nichols  
Ulanda Nichols

My Commission Expires:  
April 1, 1967 //