


Give All Information Completely
Make Required Affidavit
Mail or Deliver Report to:
Conservation Division
State Corporation Commission
211 No. Broadway
Wichita, Kansas

WELL PLUGGING RECORD

NORTH

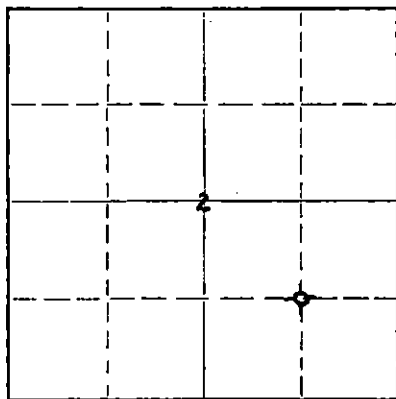

Locate well correctly on above
Section Plat

Hamilton County. Sec. 2 Twp. 24 Rge. 39 (E) (W)
Location as "NE/CNW/SW" or footage from lines C/SE/4
Lease Owner Kansas-Nebraska Natural Gas Co., Inc.
Lease Name Thomeczek Well No. 2
Office Address Hastings, Nebraska
Character of Well (completed as Oil, Gas or Dry Hole) Dry
Date well completed 10-21 19 57
Application for plugging filed 12-16 19 57
Application for plugging approved 12-18 19 57
Plugging commenced 12-22 19 57
Plugging completed 12-26 19 57
Reason for abandonment of well or producing formation Dry hole

If a producing well is abandoned, date of last production None 19
Was permission obtained from the Conservation Division or its agents before plugging was commenced? Yes

Name of Conservation Agent who supervised plugging of this well Dan Peterson, Lakin, Kansas
Producing formation Chase Group Depth to top 2524 Bottom 2494 Total Depth of Well 2540 Feet
Show depth and thickness of all water, oil and gas formations.

OIL, GAS OR WATER RECORDS

CASING RECORD

FORMATION	CONTENT	FROM	TO	SIZE	PUT IN	PULLED OUT
Chase Group	Gas & Water	2424	2494	8-5/8	317	None
				5-1/2	2539	1751

Describe in detail the manner in which the well was plugged, indicating where the mud fluid was placed and the method or methods used in introducing it into the hole. If cement or other plugs were used, state the character of same and depth placed, from feet to feet for each plug set.

Plugged back w/crushed rock to 2434', dumped 3 sax cement w/dump bailer @ 2434', top of cement 2410'. Pumped in 15 sax gel-mud @ 1700' by Acid Engineers. Filled hole w/mud to 290'. Set rock bridge, dumped 7 sax cement. Top of cement 270'. Filled hole w/mud to 10', set rock bridge, dumped 3 sax cement for cap.

1-7-58

(If additional description is necessary, use BACK of this sheet)

Name of Plugging Contractor Miller Casing Pulling Co.
Address Great Bend, Kansas

STATE OF Nebraska, COUNTY OF Adams, ss.
S. D. Ford, Jr.

(employee of owner) or (owner/operator) of the above-described well, being first duly sworn on oath, says: That I have knowledge of the facts, statements, and matters herein contained and the log of the above-described well as filed and that the same are true and correct. So help me God.

(Signature)

(Address)

SUBSCRIBED AND SWORN TO before me this 6th day of January, 1958

My commission expires
October 23, 1959

J. ROLAND MILLER

Notary Public.

