


STATE OF KANSAS
STATE CORPORATION COMMISSION

WELL PLUGGING RECORD

Give All Information Completely
Make Required Affidavit
Mail or Deliver Report to:
Conservation Division
State Corporation Commission
211 No. Broadway
Wichita, Kansas

Barton County, Sec. 12 Twp. 16 Rge. 11 (E) W (W)
Location as "NE/CNW/SW" or footage from lines SW SW SE
Lease Owner Harms-Burt Drilling Company
Lease Name Kraft Well No. #1
Office Address Box 184, Great Bend, Kansas
Character of Well (completed as Oil, Gas or Dry Hole) Dry Hole
Date well completed December 18 1957
Application for plugging filed " 18 1957
Application for plugging approved " 18 (verbally) 1957
Plugging commenced " 18 1957
Plugging completed " 18 1957
Reason for abandonment of well or producing formation Dry Hole

NORTH

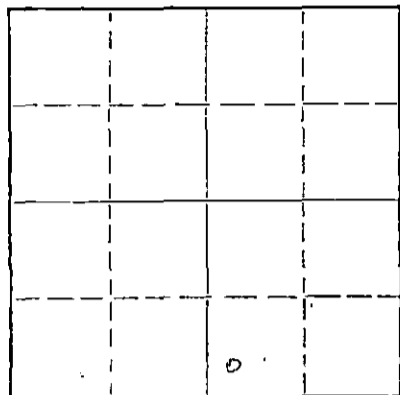

Locate well correctly on above
Section Plat

If a producing well is abandoned, date of last production _____ 19____
Was permission obtained from the Conservation Division or its agents before plugging was com-
menced? Yes

Name of Conservation Agent who supervised plugging of this well Don Truan, Route 1, Russell, Kansas
Producing formation Arbuckle Depth to top _____ Bottom _____ Total Depth of Well 3449 Feet
Show depth and thickness of all water, oil and gas formations.

OIL, GAS OR WATER RECORDS

CASING RECORD

FORMATION	CONTENT	FROM	TO	SIZE	PUT IN	PULLED OUT
Surface		0	385'	8 5/8"	385'	0

Describe in detail the manner in which the well was plugged, indicating where the mud fluid was placed and the method or methods used in introducing it into the hole. If cement or other plugs were used, state the character of same and depth placed, from _____ feet to _____ feet for each plug set.

Filled hole with heavy mud from total depth to 380' with a plug and 20 sacks of cement at this point. Heavy mud to 40' with plug and 10 sacks of cement.

RECEIVED
STATE CORPORATION COMMISSION

JAN 2 1958 01-02-58

CONSERVATION DIVISION
WICHITA, KANSAS

(If additional description is necessary, use BACK of this sheet)

Name of Plugging Contractor Harms-Burt Drilling Company
Address Box 184, Great Bend, Kansas

STATE OF Kansas, COUNTY OF Barton, ss.
Allan Harms (employee of owner) or (owner or operator) of the above-described well, being first duly sworn on oath, says: That I have knowledge of the facts, statements, and matters herein contained and the log of the above-described well as filed and that the same are true and correct. So help me God.

(Signature) Allan Harms
Box 184, Great Bend, Kansas
(Address)

SUBSCRIBED AND SWORN to before me this 30 day of DECEMBER, 1957

Mary E Van Pelt
Notary Public.

My commission expires January 20, 1958

PLUGGING
FILE SEC. 12 T. 16 R. 11W
BOOK PAGE 72 LINE 4

DRILLERS LOG

Company: Harms-Burt Drilling Co. SW SW SE, Section 12-16-11W
 Farm: Kraft #1 Barton County, Kansas
 Commenced: December 7, 1957 Completed: December 18, 1957
 Elevation: 1890 KB

0 - 180	shale
180 - 190	sand
190 - 275	red shale
275 - 315	Dakota sand
315 - 425	red bed
425 - 518	shale
518 - 700	red bed
700 - 735	anhydrite
735 - 1260	shale & shells
1260 - 1980	lime
1980 - 2025	lime - shale
2025 - 2120	shale-lime
2120 - 2165	lime & shale
2165 - 2240	shale & lime
2240 - 2430	shale
2430 - 2640	shale & shells
2640 - 2690	shale & lime
2690 - 2918	lime & shale
2918 - 2995	lime
2995 - 3039	shale
3039 - 3049	Br. lime
3049 - 3373	lime
3373 - 3416	Conglomerate
3416 - 3449	Arbuckle
3449	Total Depth

RECORDED
 JAN 2 1958
 COUNTY DIVISION
 Barton County, Kansas

Set 385' of 8 5/8" surface pipe. Cemented with 250 sacks of common cement and 2% calcium chloride.

Tops:	Anhydrite	700'
	Heebner	2938'
	Br. Lime	3039'
	Lansing K.C.	3054'
	Conglomerate	3375'
	Arbuckle	3415'

Drill Stem Test: #1 3359-3373 Open 1 1/2 Hrs. Shut in 20 min. Rec. 40' Salt water BHP-835#

Ran electric log.

Dry, plugged and abandoned.

AFFIDAVIT

State of Kansas)
) SS.
 County of Barton)

I, Allan Harms of the Harms-Burt Drilling Company being first duly sworn on oath state: I have knowledge of the facts, statements and matters herein contained and the same are true and correct.

Allan Harms

Subscribed and sworn to before me this 30 day of DECEMBER 1957

Mary E Van Belt
 Notary Public

My commission expires January 20, 1958.

PLUGGING
 FILE SEC 12 T 16 R 11W
 BOOK PAGE 72 LINE 4