


Give All Information Completely
Make Required Affidavit
Mail or Deliver Report to:
Conservation Division
State Corporation Commission
800 Bitting Building
Wichita, Kansas

15-009-00890-0000
WELL PLUGGING RECORD

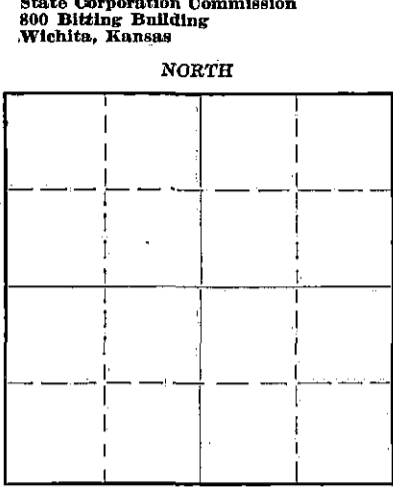

Locate well correctly on above Section Flat

Barton County, Sec. 11 Twp. 16 Rge. (E) 11(W)
Location as "NE/CNW $\frac{1}{4}$ SW $\frac{1}{4}$ " or footage from lines Sec SW SW
Lease Owner D. R. Lauck Oil Company Inc. et.al.
Lease Name Joe Pichner Well No. 1
Office Address Wichita
Character of Well (completed as Oil, Gas or Dry Hole) dry hole
Date well completed October 6 19 50
Application for plugging filed October 6 19 50
Application for plugging approved October 6 19 50
Plugging commenced October 6 19 50
Plugging completed October 6 19 50
Reason for abandonment of well or producing formation

If a producing well is abandoned, date of last production 19
Was permission obtained from the Conservation Division or its agents before plugging was commenced? yes

Name of Conservation Agent who supervised plugging of this well Stough
Producing formation Depth to top Bottom Total Depth of Well 3338 Feet
Show depth and thickness of all water, oil and gas formations.

OIL, GAS OR WATER RECORDS

CASING RECORD

Formation	Content	From	To	Size	Put In	Pulled Out
Arbuckle	water	3315	3338	10"	200'	none

Describe in detail the manner in which the well was plugged, indicating where the mud fluid was placed and the method or methods used in introducing it into the hole. If cement or other plugs were used, state the character of same and depth placed, from feet to feet for each plug set.

Mud 3338 - 200
Bridge 200 - 195
cement 195 - 155
mud 155 - 30 30
Bridge 30 22 - 26
cement 26 - 6 bottom of cellar

RECEIVED
STATE CORPORATION COMMISSION
OCT 12 1950
CONSERVATION DIVISION
Wichita, Kansas

(If additional description is necessary, use BACK of this sheet)

Correspondence regarding this well should be addressed to D. R. Lauck Oil Company Inc.
Address Wichita, Kansas

STATE OF Kansas COUNTY OF Sedgwick, ss.
P. R. Bishop (employee of owner) or (owner or operator) of the above-described well,
being first duly sworn on oath, says: That I have knowledge of the facts, statements, and matters herein contained and the log of the above-described well as filed and that the same are true and correct. So help me God.

(Signature) *P. R. Bishop*
Wichita, Kansas
(Address)

SUBSCRIBED AND SWORN TO before me this 11 day of October, 19 50

My commission expires Sept. 14, 1951

Elizabeth Gay
Notary Public

22-5133-s 9-48-10M
PLUGGING
FILE SEC. 11 T. 16 R. 16 W
BOOK PAGE 33 LINE 25

D. H. LAUCK OIL COMPANY ET. AL. (Inc.)

Joe Pichner #1

Sec. 11 T 16S. R11W.
Barton County Kansas

880 SW 88

Commenced Sept. 24, 1950

Completed Oct. 6, 1950

Casing: 10" 200' cemented 125 sacks

Shale & shells	65
sand	80
shale & shells	105
Red Rock	100
shale & shells	665
Anhydrite	505
shale & shells	1000
salt & shale	1085
shale & shells	1335
shale & lime	2205
shale	2315
shale & lime	2605
Lime	3300
Conglomerate	3317
Lime	3340

Drill stem tests:

3219 - 3332 work blow
 40' 100' slight oil cut mud
 3319 - 3340 work blow
 100' water cut mud

Dry and abandoned

Top Derrick Floor

Elevation	1841
Sealbox	2071
Brown line	2960
White line	2985
Conglomerate	3290
Arbuckle	3315
Total Depth	3330

PLUGGING
 TRUE SEC-11-T-16-R11W
 BOOK PAGE-33-LINE-25

RECEIVED
STATE CORPORATION COMMISSION

OCT 12 1950

CONSERVATION DIVISION
Wichita, Kansas