


STATE OF KANSAS
STATE CORPORATION COMMISSION

Give All Information Completely
Make Required Affidavit
Mail or Deliver Report to:
Conservation Division
State Corporation Commission
212 No. Market
Wichita, Kansas

WELL PLUGGING RECORD

15-009-30332-0000
Form CP-4

NORTH

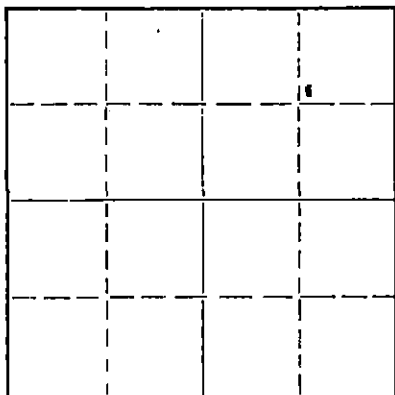

Locate well correctly on above
Section Plat

Barton County, Sec. 11 Twp. 16S Rge. (E) 11 (W)

Location as "NE/CNW/SW" or footage from lines SW NE NE
Lease Owner Newman's, Inc.
Lease Name Houska Well No. 1
Office Address 700 Petroleum Club Bldg., Tulsa, Oklahoma
Character of Well (completed as Oil, Gas or Dry Hole) Dry Hole
Date well completed 4-20-66 19
Application for plugging filed 4-20-66 19
Application for plugging approved 4-20-66 19
Plugging commenced 11:30 A.M. 19
Plugging completed 1:30 P.M. 4-20-66 19
Reason for abandonment of well or producing formation Dry

If a producing well is abandoned, date of last production 19
Was permission obtained from the Conservation Division or its agents before plugging was commenced? Yes

Name of Conservation Agent who supervised plugging of this well Don Truan
Producing formation None Depth to top Bottom Total Depth of Well 3311 Feet
Show depth and thickness of all water, oil and gas formations.

OIL, GAS OR WATER RECORDS

CASING RECORD

FORMATION	CONTENT	FROM	TO	SIZE	PUT IN	PULLED OUT
Soil Post Rock & Shale		0	278'	8 5/7"	278'	None

Describe in detail the manner in which the well was plugged, indicating where the mud fluid was placed and the method or methods used in introducing it into the hole. If cement or other plugs were used, state the character of same and depth placed, from feet to feet for each plug set.

Mud to 278' plug & 1/4 sack hulls, Mixed 25 sacks cement through
drill pipe. Mud to 40' plug & 1/2 sack hulls & 12 sacks cement through
rat hole with 3 sacks cement.

RECEIVED
APR 25 1966
CONSERVATION DIVISION
WICHITA, KANSAS
04-25-66

(If additional description is necessary, use BACK of this sheet)

Name of Plugging Contractor B & B DRILLING, INC.
Address 548 Petroleum Bldg., Wichita, Kansas 67202

STATE OF KANSAS, COUNTY OF SEDGWICK, ss.
Bill E. Lahar, President (employee of owner) or (owner or operator) of the above-described well, being first duly sworn on oath, says: That I have knowledge of the facts, statements, and matters herein contained and the log of the above-described well as filed and that the same are true and correct. So help me God.

(Signature) Bill Lahar President

548 Petroleum Bldg., Wichita, Kansas
(Address)

SUBSCRIBED AND SWORN TO before me this 23rd day of April, 1966

My commission expires January 12, 1970

Twyla Nadine Coleman
Notary Public.

B & B DRILLING, INC.

548 Petroleum Building

Wichita, Kansas 67202

April 23, 1966

DRILLERS LOG

Re: #1 Houska
SW NE NE Sec. 11-16S-11W
Barton County, Kansas

COMPANY: NEWMAN'S, INC.
CONTRACTOR: B & B DRILLING, INC.
TOTAL DEPTH: 3311'
COMMENCED: 4-15-66
COMPLETED: 4-20-66

0	278'	Surface Hole
278	910	Shale & Redbed
910	1330	Shale
1330	1465	Lime & Shale
1465	1760	Lime & Shale
1760	2000	Lime
2000	2375	Shale & Shells
2375	2574	Shale & Lime
2574	2740	Lime & Shale
2740	3160	Lime & Shale
3160	3200	Lime & Shale
3200	3225	Lime
3225	3301	Lime
3301	3311	Arbuckle
	3311	Total Depth

We certify the above and foregoing to be a true
and correct copy of the log on the #1 Houska,
located in Barton County, Kansas.

B & B DRILLING, INC.

Bill Lahar

Bill Lahar
President

Subscribed and sworn to before
me this 23rd day of April, 1966.

January 12, 1970

Theresa Marie Coleman
Notary Public

RECEIVED
STATE CORPORATION COMMISSION

APR 25 1966

CONFIRMATION FILED
WICHITA, KANSAS