

STATE OF KANSAS
STATE CORPORATION COMMISSION

Form CP-4
15-097-00112-0001
WELL PLUGGING RECORD

Give All Information Completely
Make Required Affidavit
Mail or Deliver Report to:
Conservation Division
State Corporation Commission
212 No. Market
Wichita, Kansas

Kiowa County, Sec. 8 Twp. 30S Rge. 18W (E) (W)

Location as "NE/CNW/SW" or footage from lines C SE NW

Lease Owner J. M. Huber Corporation

Lease Name Parkin Well No. 1

Office Address P. O. Box 911, Amarillo, Texas 79105

Character of Well (completed as Oil, Gas or Dry Hole) Gas

Date well completed January 19 59

Application for plugging filed July 7 19 70

Application for plugging approved July 9 19 70


Plugging commenced August 11 19 70

Plugging completed August 12 19 70

Reason for abandonment of well or producing formation uneconomical

If a producing well is abandoned, date of last production 19

Was permission obtained from the Conservation Division or its agents before plugging was commenced? Yes

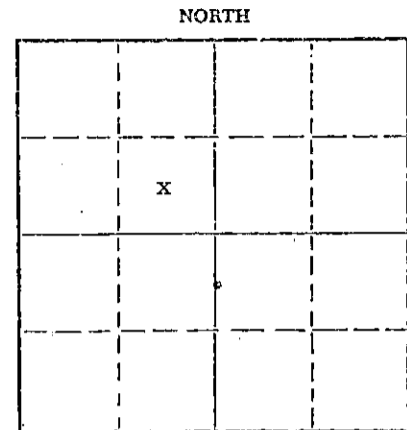

Locate well correctly on above Section Plat

Name of Conservation Agent who supervised plugging of this well Mr. G. Russell Biberstein

Producing formation Mississippian Chert Depth to top 4994 Bottom 5116 Total Depth of Well 5116 Feet

Show depth and thickness of all water, oil and gas formations.

OIL, GAS OR WATER RECORDS

CASING RECORD

FORMATION	CONTENT	FROM	TO	SIZE	PUT IN	PULLED OUT
Mississippian	Chert	4994	5116	8-5/8"	405'	-0-
				5-1/2"	5104'	3042'

Describe in detail the manner in which the well was plugged, indicating where the mud fluid was placed and the method or methods used in introducing it into the hole. If cement or other plugs were used, state the character of same and depth placed, from _____ feet to _____ feet for each plug set.

Spotted 50 sacks cement plug from 4900'-4500'; filled with mud laden fluid to 455'; spotted 50 sacks cement plug from 455'-355'; filled with mud laden fluid to 30'; spotted 10 sacks cement plug from 30'-0'. Job complete.

RECEIVED
STATE CORPORATION COMMISSION
AUG 27 1970
CONSERVATION DIVISION
Wichita, Kansas

(If additional description is necessary, use BACK of this sheet)

Name of Plugging Contractor Lillard Casing Crew - Woodward Oklahoma

Address _____

STATE OF Texas, COUNTY OF Potter, ss. Bob Conley

(employee of owner) or (owner or operator) of the above-described well, being first duly sworn on oath, says: That I have knowledge of the facts, statements, and matters herein contained and the log of the above-described well as filed and that the same are true and correct. So help me God.

(Signature) Bob Conley

P. O. Box 911, Amarillo, Texas 79105 (Address)

SUBSCRIBED AND SWORN TO before me this 18th day of August, 1970

My commission expires June 1, 1971

Notary Public. Pat Benson

RECEIVED
STATE CORPORATION COMMISSION

Parkin #1
Section 8-T30S-R18W
Kiowa County, Kansas

JUL 9 1970
CONSERVATION DIVISION
Wichita, Kansas

Driller's Log

<u>Depth</u>	<u>Formation</u>
0'-470'	Sand, Shale
470'-700'	Shale, Anhydrite
700'-1130'	Red Beds
1130'-1915'	Sand, Shale
1915'-2135'	Shale
2135'-3246'	Lime, Shale
3246'-3630'	Shale
3630'-4175'	Lime, Shale
4175'-4209'	Heebner Shale
4209'-4355'	Douglas
4355'-4373'	Brown Lime
4373'-4809'	Lansing
4809'-4899'	Marmaton
4899'-4991'	Cherokee
4991'-4994'	Mississippian
4994'-5116' (TD)	Mississippian Chert

Certificate:

I hereby certify the foregoing statements are true and correct to the best of my knowledge and belief.


Bob Conley

Title: District Production Clerk

Subscribed and sworn to before me, a Notary Public,

this 7th day of July 1970.


Notary Public