


STATE OF KANSAS
STATE CORPORATION COMMISSION

Give All Information Completely
Make Required Affidavit
Mail or Deliver Report to:
Conservation Division
State Corporation Commission
211 No. Broadway
Wichita, Kansas

WELL PLUGGING RECORD

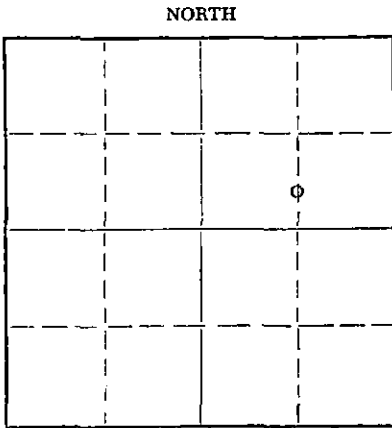

Locate well correctly on above
Section Plat

Kiowa County. Sec. 8 Twp. 30S Rge. (E) 18(W)
Location as "NE/CNW/SW" or footage from lines c S/2 S/2 NE/4
Lease Owner K & E Drilling, Inc.
Lease Name H. P. Parkin Well No. 1
Office Address 816 Union Center Bldg.
Character of Well (completed as Oil, Gas or Dry Hole) Dry Hole
Date well completed August 26 1972
Application for plugging filed August 26 1972
Application for plugging approved August 26 1972
Plugging commenced August 26 1972
Plugging completed August 26 1972
Reason for abandonment of well or producing formation Dry Hole

If a producing well is abandoned, date of last production _____ 19____
Was permission obtained from the Conservation Division or its agents before plugging was commenced? Yes

Name of Conservation Agent who supervised plugging of this well G. R. Biberstein Attica, Kansas
Producing formation _____ Depth to top _____ Bottom _____ Total Depth of Well 5044 Feet
Show depth and thickness of all water, oil and gas formations.

OIL, GAS OR WATER RECORDS

CASING RECORD

| FORMATION | CONTENT | FROM | TO | SIZE | PUT IN | PULLED OUT |
|-----------|---------|------|-------|--------|--------|------------|
| | | 0 | 1113' | 8 5/8" | 1113' | None |
| | | | | | | |
| | | | | | | |
Describe in detail the manner in which the well was plugged, indicating where the mud fluid was placed and the method or methods used in introducing it into the hole. If cement or other plugs were used, state the character of same and depth placed, from _____ feet to _____ feet for each plug set.

Plug: 450' w/40 sacks cement
40' w/15 sacks cement
2 sacks cement in rat hole

RECEIVED
STATE CORPORATION COMMISSION
PCW
08-31-72 AUG 31 1972
CONSERVATION DIVISION
Wichita, Kansas

(If additional description is necessary, use BACK of this sheet)


Name of Plugging Contractor Hellar Drilling Company, Inc.
Address 339 Union Center Bldg., Wichita, Kansas 67202

STATE OF Kansas, COUNTY OF Sedgwick, ss.
D. L. Hellar, President of Hellar Drlg. Co. Inc. (employee of owner) or (owner or operator) of the above-described well, being first duly sworn on oath, says: That I have knowledge of the facts, statements, and matters herein contained and the log of the above-described well as filed and that the same are true and correct. So help me God.

(Signature) [Signature] D. L. Hellar, President
339 Union Center Bldg., Wichita, Kansas 67202
(Address)

Subscribed and Sworn to before me this 29th day of August, 1972
Catherine Darcey
Catherine Darcey - - Notary Public.

My commission expires March 25, 1976

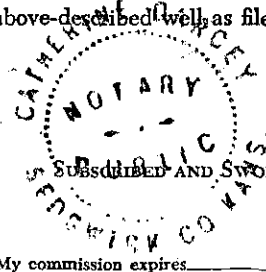

DRILLER'S LOG

COMPANY: K & E Drilling, Inc., 816 Union Center Bldg., Wichita, Kansas 67202
CONTRACTOR: Hellar Drilling Company, Inc., Wichita, Kansas 67202
LEASE: #1 H. P. Parkin
LOCATION: c S/2 S/2 NE/4 8-30S-18W, Kiowa County, Kansas
COMMENCED: August 11, 1972
COMPLETED: August 26, 1972
CASING: Set 8 5/8" Surface Casing @ 1113' w/550 sacks cement

| | |
|-----------|--|
| 0-197 | Surface Soil, Shale, Red Bed & Post Rock |
| 197-573 | Shale & Red Bed & Post Rock |
| 573-587 | Blaine Anhydrite |
| 587-1113 | Shale & Red Bed |
| 1113-2260 | Red Bed & Salt Section |
| 2260-2754 | Salt Section & Lime |
| 2754-3188 | Lime & Shale (Ft. Riley) |
| 3188-3334 | Lime |
| 3334-3438 | Lime & Shale |
| 3438-3631 | Lime & Shale (Waub. 3517') |
| 3631-4028 | Lime & Shale |
| 4028-4178 | Lime & Shale (Topeka) |
| 4178-4205 | (Heebner) |
| 4205-4310 | Lime & Shale (Douglas) |
| 4310-4327 | (Brown Lime) |
| 4327-4392 | Douglas Shale Section |
| 4392-4768 | Lime (K.C.) (B.K.C. 4768') |
| 4768-4935 | Lime (Marmaton) |
| 4935-5003 | Lime |
| 5003-5044 | Miss. |
| 5044 | Rotary Total Depth |

D & A

RECEIVED
STATE CORPORATION COMMISSION
AUG 31 1972
CONSERVATION DIVISION
Wichita, Kansas

STATE OF KANSAS)
) SS
COUNTY OF SEDGWICK)

I, D. L. Hellar, do hereby certify that the above and foregoing is a true and correct copy of the log of the #1 H. P. Parkin, located in c S/2 S/2 NE/4 8-30S-18W, Kiowa County, Kansas, as reflected by the files of the Hellar Drilling Company, Inc.

HELLAR DRILLING COMPANY, INC.

By *D. L. Hellar*
President - D. L. Hellar

Subscribed and sworn to before me, a Notary Public, in and for Sedgwick County, Kansas, this 29th day of August, 1972.

Catherine Darcey
Notary Public - Catherine Darcey

My Commission Expires:
March 25, 1976.

