

Give All Information Completely
Make Required Affidavit
Mail or Deliver Report to:
Conservation Division
State Corporation Commission
211 No. Broadway
Wichita, Kansas


WELL PLUGGING RECORD

15-009-01559-0000

Barton County, Sec. 7 Twp. 16 Rge. 11 (E) (W) x

Location as "NE/CNW/SW" or footage from lines SE SW NE
Lease Owner Herman George Kaiser
Lease Name Esfeld "C" Well No. #2
Office Address Box 666, Ellinwood, Kansas
Character of Well (completed as Oil, Gas or Dry Hole) _____
Date well completed _____ 19____
Application for plugging filed _____ 19____
Application for plugging approved _____ 19____
Plugging commenced 6-22-64 _____ 19____
Plugging completed 6-24-64 _____ 19____
Reason for abandonment of well or producing formation _____

NORTH

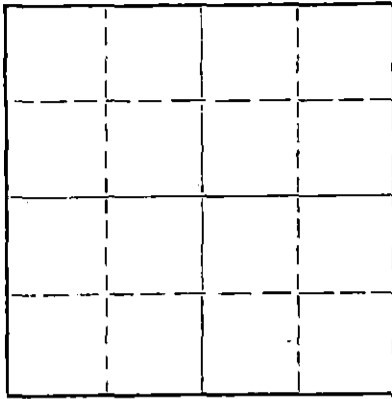

Locate well correctly on above
Section Plat

If a producing well is abandoned, date of last production _____ 19____
Was permission obtained from the Conservation Division or its agents before plugging was commenced? _____

Name of Conservation Agent who supervised plugging of this well Donald Truan
Producing formation _____ Depth to top _____ Bottom _____ Total Depth of Well 3257' Feet
Show depth and thickness of all water, oil and gas formations.

OIL, GAS OR WATER RECORDS

CASING RECORD

FORMATION	CONTENT	FROM	TO	SIZE	PUT IN	PULLED OUT
						2666.93'

Describe in detail the manner in which the well was plugged, indicating where the mud fluid was placed and the method or methods used in introducing it into the hole. If cement or other plugs were used, state the character of same and depth placed, from _____ feet to _____ feet for each plug set.

Sanded back to 3240', mixed and ran 5 sacks cement thru dump bailer.

Mudded hole to 240', set 10' rock bridge. Mixed and ran 25 sacks cement thru dump bailer.

Mudded hole to 40', set 10' rock bridge, mixed and dumped 10 sacks cement to base of cellar.

RECEIVED
STATE CORPORATION COMMISSION

JUN 26 1964
6-26-64
CONSERVATION DIVISION
Wichita, Kansas

(If additional description is necessary, use BACK of this sheet)

Name of Plugging Contractor Southwest Casing Pulling Co., Inc.
Address Box 364, Great Bend, Kansas

STATE OF Kansas, COUNTY OF Barton, ss.

Southwest Casing Pulling Co., Inc. (employee of owner) or (owner or operator) of the above-described well, being first duly sworn on oath, says: That I have knowledge of the facts, statements, and matters herein contained and the log of the above-described well as filed and that the same are true and correct. So help me God.

(Signature) W. C. Spencer
Box 364, Great Bend, Kansas
(Address)

SUBSCRIBED AND SWORN TO before me this 25 day of June, 19 64

My commission expires 24 October 1964

Indray D. Mill
Notary Public.

KANSAS GEOLOGICAL SOCIETY
KANSAS WELL LOG BUREAU - KANSAS WELL SAMPLE BUREAU
 KANSAS GEOLOGICAL SOCIETY BUILDING
 508 EAST MURDOCK - WICHITA, KANSAS

orig to SCC
 copy to Ks. Geol. Soc.

15-009-01559-0000












RECEIVED
 STATE CORPORATION COMMISSION
 JUN 11 1954
 6-11-1954
 CONSERVATION DIVISION
 Wichita, Kansas

I hereby certify that the above and foregoing is a true and correct log of the above described well, as shown by the drilling records.

W. J. D. S.

Francis M. Jensen
 Francis M. Jensen

STATE OF KANSAS)
)
 SARFORD COUNTY)

Subscribed and sworn to before me, a Notary Public in and for said county and state, this 10th day of June, 1954.

Genevieve Hayes
 Genevieve Hayes, Notary Public

By Conservation Division
 October 1, 1954.