


15-009-03016-0000

STATE OF KANSAS
STATE CORPORATION COMMISSION

Form CP-4

Give All Information Completely
Make Required Affidavit
Mail or Deliver Report to:
Conservation Division
State Corporation Commission
P. O. Box 17027
Wichita, Kansas 67217

WELL PLUGGING RECORD

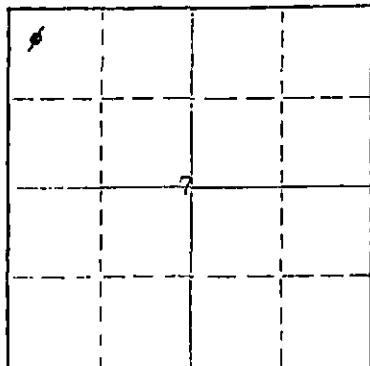

Locate well correctly on above
Section Plat

Barton County, Sec. 7 Twp. 16 Rge. (E) 11 (W)
Location as "NE/CNW/SE/SW" or footage from lines NW NW NW
Lease Owner Lario Oil & Gas Company
Lease Name Esfeld Well No. 1
Office Address 301 S. Market, Wichita, Kansas 67202
Character of Well (completed as Oil, Gas or Dry Hole) Oil
Date well completed November 5 19 75
Application for plugging filed September 15 19 75
Application for plugging approved September 16 19 75
Plugging commenced September 18 19 75
Plugging completed September 25 19 75
Reason for abandonment of well or producing formation Depleted

If a producing well is abandoned, date of last production January 31 19 75
Was permission obtained from the Conservation Division or its agents before plugging was commenced? Yes

Name of Conservation Agent who supervised plugging of this well _____
Producing formation Arbuckle Depth to top 3210 Bottom 3222 Total Depth of Well 3323 1/2 feet
Show depth and thickness of all water, oil and gas formations.

OIL, GAS OR WATER RECORDS

CASING RECORD

FORMATION	CONTENT	FROM	TO	SIZE	PUT IN	PULLED OUT
				8 5/8"	457	None
				5 1/2"	3313	1616'

Describe in detail the manner in which the well was plugged, indicating where the mud fluid was placed and the method or methods used in introducing it into the hole. If cement or other plugs were used, state the character of same and depth placed, from _____ feet to _____ feet for each plug set.

Plugged off bottom with sand and 5 sacks of cement. Pulled 52 jts. of casing.
Pumped in 3 sacks of hulls, 25 sacks of gel, and 100 sacks of cement from 0'
to 300'. Pumping pressure 600#. Shut in pressure 300#.

RECEIVED
STATE CORPORATION COMMISSION

OCT 14 1975
10-14-75
CONSERVATION DIVISION
Wichita, Kansas

(If additional description is necessary, use BACK of this sheet)
Name of Plugging Contractor Knight Casing Pulling Co., Inc.
Address Box 405, Chase, Kansas 67524

STATE OF Kansas COUNTY OF Sedgwick, ss.
M. E. Kraft (employee of owner) or ~~owner or operator~~

well, being first duly sworn on oath, says: That I have knowledge of the facts, statements, and matters herein contained and the log of the above-described well as filed and that the same are true and correct. So help me God.

(Signature) M. E. Kraft
301 S. Market, Wichita, Kansas 67202
(Address)

SUBSCRIBED AND SWORN TO before me this 10th day of October, 19 75

My commission expires July 21, 1978
Frances Leslie Notary Public.

WELL LOG BUREAU—KANSAS GEOLOGICAL SOCIETY.
412 Union National Bk. Bldg., Wichita, Kansas


15-009-03016-0000

Company - PHIL-HAN OIL COMPANY
Farm - Esfeld No. 1

SEC. 7 T. 16 R. 11 W
NWc NW

Total Depth. 3323½'
Comm. 10-24-44 Comp. 11-5-44
Shot or Treated.
Contractor.
issued. 1-27-45

County. Barton
KANSAS

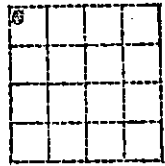

Elevation. _____

Production. Pot. 1356 B.

CASING:

.8 5/8" 457' Cem.
5 1/2" 3313' Cem.

Figures Indicate Bottom of Formations.

rock & slate	20
shale & shells	320
sand & shale	457
sand hrd	470
shale	580
red rock	675
shale	750
anhydrite	775
shale & lime	1020
shale	1090
salt	1425
shale & lime	1520
lime	1725
shale & lime	1840
lime	1950
lime & shale	2445
shale	2500
lime & shale	2730
lime	2855
shale & lime	2920
lime	2968
shale	2980
shale & lime	3045
lime brkn	3105
lime	3323½'
Total Depth.	

Top K. C. 3025
Top Arbuckle 3311
Show Oil 2876-84
2892-02
Sat. & Por. 3066-71
Pay 3210-22
Filled up 2500' in 4 hours.

3025
1891
1331

RECEIVED
STATE CORPORATE COMMISSION

SEP 16 1975

CONSERVATION DIVISION
Wichita, Kansas

3210
1891
-1319
12
-1331

1389
1191
-168