


STATE OF KANSAS  
STATE CORPORATION COMMISSION  
Give All Information Completely  
Make Required Affidavit  
Mail or Deliver Report to:  
Conservation Division  
State Corporation Commission  
800 Bittling Building  
Wichita, Kansas

WELL PLUGGING RECORD

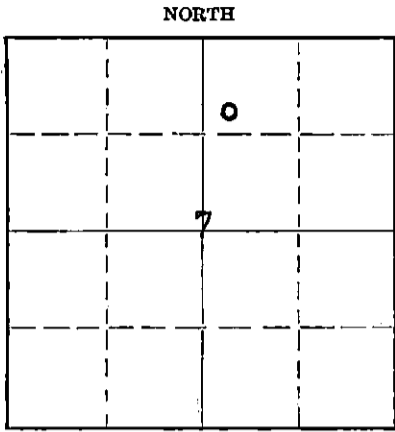

Locate well correctly on above Section Plat

Barton County. Sec. 7 Twp. 16 Rge. 11 (E) (W)  
Location as "NE/CNW $\frac{1}{4}$ SW $\frac{1}{4}$ " or footage from lines SW NW NE  
Lease Owner The El Dorado Refining Co.  
Lease Name ESFELD Well No. 1  
Office Address Box 209 - Russell, Kansas  
Character of Well (completed as Oil, Gas or Dry Hole) Dry Hole  
Date well completed 8-22-19 50  
Application for plugging filed 9-5-19 50  
Application for plugging approved 9-6-19 50  
Plugging commenced 9-12-19 50  
Plugging completed 9-15-19 50  
Reason for abandonment of well or producing formation Dry

If a producing well is abandoned, date of last production 19  
Was permission obtained from the Conservation Division or its agents before plugging was commenced? Yes

Name of Conservation Agent who supervised plugging of this well C. D. Stough  
Producing formation Depth to top Bottom Total Depth of Well 3316' Feet  
Show depth and thickness of all water, oil and gas formations.


OIL, GAS OR WATER RECORDS

CASING RECORD

Formation	Content	From	To	Size	Put In	Pulled Out
				8-5/8"	300'	000
				5 1/2"	2938'	2663'

Describe in detail the manner in which the well was plugged, indicating where the mud fluid was placed and the method or methods used in introducing it into the hole. If cement or other plugs were used, state the character of same and depth placed, from feet to feet for each plug set.

Filled hole with sand from 2860' to 2820' then run 5 sacks fo cement at 2820' - then mudded up to 300'. Set bridge and run 15 sacks of cement at 300' - mudded up to 25' of base of cellar - then run 10 sacks of cement on top to cap.

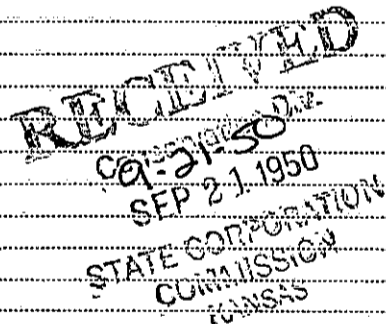

(If additional description is necessary, use BACK of this sheet)  
Correspondence regarding this well should be addressed to Mr. Levi B. Sherman - ElDorado Refg. Co.  
Address Box 209 - Russell, Kansas


STATE OF KANSAS, COUNTY OF RUSSELL, ss.  
Levi B. Sherman (employee of owner) or (owner or operator) of the above-described well, being first duly sworn on oath, says: That I have knowledge of the facts, statements, and matters herein contained and the log of the above-described well as filed and that the same are true and correct. So help me God

(Signature) Levi B. Sherman  
Box 209 - Russell, Kansas (Address)

SUBSCRIBED AND SWORN to before me this 20 day of September, 19 50

Verel J. Buck Notary Public

My commission expires 10-13-52

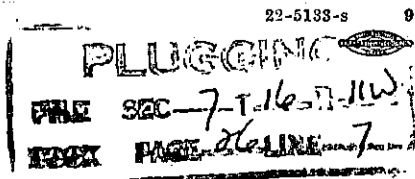

15-009-06347-0000

# THE EL DORADO REFINING COMPANY

EL DORADO, KANSAS

WELL LOG

ESFELD #1

Location: SW/4 NW/4 NE/4 of Section 7-16-11, Barton County, Kansas

Owner - The El Dorado Refining Co.  
Contractor - Sterling Drilling Company

Commenced - 8-5-50  
Completed - 8-18-50 (w/r)

Total Depth - 3316' (w/r)

## LOG

0- 285'	Clay & shale
285- 300	Shale
300- 500	Shale and sand
500- 710	Shale & red bed
710- 735	Anhydrite
735- 795	Shale and shells
795-1250	Shale & red bed
1250-1290	Salt
1290-1380	Shale
1380-1970	Lime
1970-2063	Lime and Shale
2063-2215	Shale and shells
2215-2400	Shale
2400-2510	Lime and shale
2510-2565	Shale
2565-2660	Lime and shale
2660-3250	Lime
3250-3280	Lime and shale
3280-3312	Arbuckle & Conglom.
3312-3316	Lime

## CASING RECORD

300' of 8-5/8" casing set & cemented with 150 sacks cement.

5 1/2" casing set at 2938' ~~with~~ with 60 sacks of cement. Cemented casing with packer shoe Top of cement at 2660'

Perforated at 2906 to 2908'  
Perforated at 2830 to 2832'  
Set plug at 2860' - pay was dry.

LOGGING  
 FILE SEC 7-16-R(10)  
 BOOK PAGE 26 LINE 7

SEP 8 1950