


WELL PLUGGING RECORD
 OR
 FORMATION PLUGGING RECORD

15-09-07185-0000

Strike out upper line
 when reporting plug-
 ging off formations.

Barton County, Sec. 7 Twp. 16S Rge. 11 (E) (W)

Location as "NE $\frac{1}{4}$ NW $\frac{1}{4}$ SW $\frac{1}{4}$ " or footage from lines. 660' north of south line, 660' west of east line.
 Lease Owner. Gulf Oil Corporation
 Lease Name. V. Staudinger Well No. 1
 Office Address. Box 661, Tulsa, Okla.
 Character of Well (completed as Oil, Gas or Dry Hole) Oil
 Date well completed. April 21 1942
 Application for plugging filed. 3-15-48 19
 Application for plugging approved. 3-16-48 19
 Plugging commenced. 5-9-48 19
 Plugging completed. 5-17-48 19
 Reason for abandonment of well or producing formation. Oil depleted
 If a producing well is abandoned, date of last production. December 19, 1945 19
 Was permission obtained from the Conservation Division or its agents before plugging was commenced? Yes

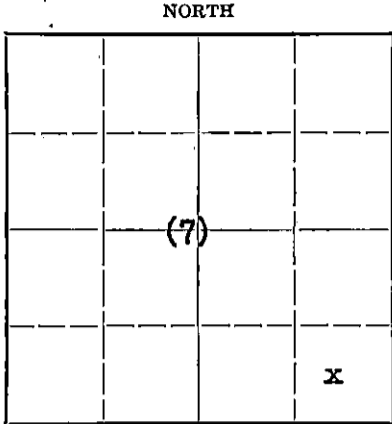

Locate well correctly on above Section Plat

Name of Conservation Agent who supervised plugging of this well. C. D. Stough
 Producing formation. Arbuckle Lime Depth to top. 3284' Bottom. 3291' Total Depth of Well. 3291 Feet
 Show depth and thickness of all water, oil and gas formations.

OIL, GAS OR WATER RECORDS

CASING RECORD

Formation	Content	From	To	Size	Put In	Pulled Out
				8-5/8"	324'	None
				5-1/2"	3285'	2494'

Describe in detail the manner in which the well was plugged, indicating where the mud fluid was placed and the method or methods used in introducing it into the hold. If cement or other plugs were used, state the character of same and depth placed, from _____ feet to _____ feet for each plug set.

Ran bailer and found hole clean to TD 3291'. Dumped 6 sacks cement on bottom.
 Ripped 5 $\frac{1}{2}$ " casing at 2500' and 2400'. Would not release. Spotted oil and casing released. Pulled and recovered 2494' of 5 $\frac{1}{2}$ " casing. Mudded hole to 324'. Dumped 20 sacks cement. Mudded hole to 35'. Capped with 7 sacks cement.

MAY 26 1948
 5-26-48

(If additional description is necessary, use BACK of this sheet)

Correspondence regarding this well should be addressed to. A. M. Bell, Jr. - Gen. Supt.
 Address. Box 661, Tulsa, Okla.

STATE OF Kansas, COUNTY OF Rice, ss.
 H. H. Wright (employee of owner) ~~operator~~ of the above-described well, being first duly sworn on oath, says: That I have knowledge of the facts, statements, and matters herein contained and the log of the above-described well as filed and that the same are true and correct. So help me God.

(Signature) *H. H. Wright*
 Box 544, Chase, Kansas
 (Address)

SUBSCRIBED AND SWORN TO before me this 18th day of May, 1948

My commission expires May 18, 1950 Notary Public.

PLUGGING
 FILE SEC 7 T16 R11W
 BOOK PAGE 18 LINE 17

