


Give All Information Completely
Make Required Affidavit
Mail or Deliver Report to:
Conservation Division
State Corporation Commission
211 No. Broadway
Wichita, Kansas

WELL PLUGGING RECORD

KINGMAN County, Sec. 30 Twp. 30S Rge. 8 (X) (W)

Location as "NE/CNW&SW&" or footage from lines NE SE NW
Lease Owner PETROLEUM, INC.
Lease Name RICHARDSON UNIT Well No. 1
Office Address ROUTE #2, GREAT BEND, KANSAS
Character of Well (completed as Oil, Gas or Dry Hole) DRY HOLE
Date well completed SEPT. 22 19 65
Application for plugging filed SEPT. 22 19 65
Application for plugging approved SEPT. 22 19 65
Plugging commenced SEPT. 22 19 65
Plugging completed SEPT. 22 19 65
Reason for abandonment of well or producing formation NO PRODUCIBLE ZONE

NORTH

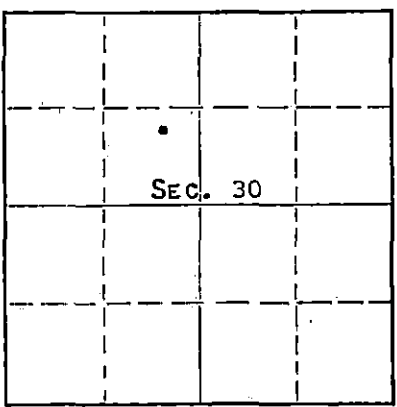

Locate well correctly on above Section Plat

If a producing well is abandoned, date of last production NONE 19
Was permission obtained from the Conservation Division or its agents before plugging was commenced? YES

Name of Conservation Agent who supervised plugging of this well ARCHIE ELYING
Producing formation _____ Depth to top _____ Bottom _____ Total Depth of Well 4406 Feet
Show depth and thickness of all water, oil and gas formations.

OIL, GAS OR WATER RECORDS

CASING RECORD

FORMATION	CONTENT	FROM	TO	SIZE	PUT IN	PULLED OUT
				8-5/8"	236	NONE

Describe in detail the manner in which the well was plugged, indicating where the mud fluid was placed and the method or methods used in introducing it into the hole. If cement or other plugs were used, state the character of same and depth placed, from _____ feet to _____ feet for each plug set.

MUDDED UP WITH HEAVY MUD THROUGH DRILL PIPE TO 225', FOLLOWED BY WOODEN PLUG, PLACED 1/4 SACK HULLS AND 25 SACKS CEMENT ON TOP OF PLUG. MUDDED UP WITH HEAVY MUD TO 40', FOLLOWED BY WOODEN PLUG, PLACED 1/4 SACK HULLS AND 10 SACKS CEMENT ON TOP OF PLUG TO BASE OF WELL CELLAR.

RECEIVED
STATE CORPORATION COMMISSION

OCT 4 1965
10-4-65
CONSERVATION DIVISION
Wichita, Kansas

(If additional description is necessary, use BACK of this sheet)
Name of Plugging Contractor GARVEY DRILLING CO.
Address R.R. #2, GREAT BEND, KANSAS

STATE OF KANSAS COUNTY OF BARTON, ss.
MONTE CHADD (employee of owner) or (~~owner or operator~~) of the above-described well, being first duly sworn on oath, says: That I have knowledge of the facts, statements, and matters herein contained and the log of the above-described well as filed and that the same are true and correct. So help me God. MONTE CHADD, DIST. PROD. SUPT.

(Signature) Monte Chadd
R.R. #2, GREAT BEND, KANSAS
(Address)

SUBSCRIBED AND SWORN to before me this 1 day of OCTOBER, 19 65

My commission expires MAY 28, 1969
Richard H. Dangler
Notary Public.

WELL LOG

15-095-30258-0000

COMPANY Petroleum, Inc
FARM Richardson Unit NO. 1

SEC. 30 T. 30S R. 8W


LOC. NE SE NW

TOTAL DEPTH 4406'

COUNTY Kingman

COMM. 9-11-65 COMP. 9-22-65

CONTRACTOR Garvey Drilling Company

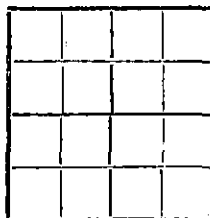

CASING 8 5/8" @ 236' w/175 sx

ELEVATION 1637' DF

PRODUCTION D & A

FIGURES INDICATE BOTTOM OF FORMATIONS

- 40' Sand and Shale
- 85' Shale
- 340' Red Bed
- 1390' Red Bed and Shale
- 1740' Shale and Lime
- 2026' Lime
- 2730' Shale and Lime
- 2850' Lime
- 2976' Lime and Shale
- 3030' Lime (Topeka)
- 3076' Lime
- 3395' Shale and Lime
- 3490' Lime and Shale
- 3580' Sand
- 3795' Lime
- 3885' Lime and Shale
- 4005' Lime
- 4062' Lime (Kansas City)
- 4198' Lime
- 4249' Lime and Shale
- 4289' Lime
- 4320' Shale (Conglomerate)
- 4345' Lime (Cherty)
- 4385' Mississippi Lime
- 4406' Lime
- 4406' RTD

RECEIVED
STATE CORPORATION COMMISSION

OCT 4 1965

CONSERVATION DIVISION
Wichita, Kansas

State of Kansas
County of Barton } 85

I, Sam N. Stephens of Garvey Drilling Company

upon oath state the above and foregoing is a true and correct copy of the log of the Richardson Unit No. 1 well.

Sam N. Stephens

Subscribed and sworn to before me this 1st day of October 19 65

My Commission Expires: May 28, 1969

Richard H. Dumbler
NOTARY PUBLIC