


Give All Information Completely
Make Required Affidavit
Mail or Deliver Report to:
Conservation Division
State Corporation Commission
800 Bittling Building
Wichita, Kansas

WELL PLUGGING RECORD
OR
FORMATION PLUGGING RECORD

15-009-06488-0000

Strike out upper line
when reporting plug-
ging of formations.

NORTH

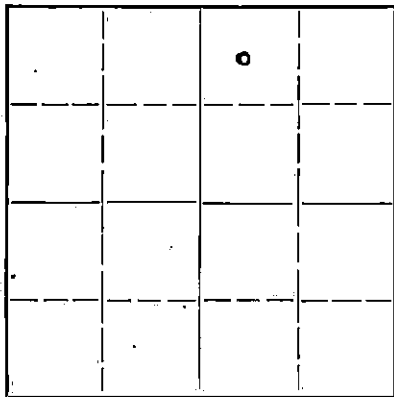

Locate well correctly on above
Section Flat

Barton County, Sec. 17 Twp. 16S Rge. (E) 11 (W)

Location as "NE $\frac{1}{4}$ NW $\frac{1}{4}$ SW $\frac{1}{4}$ " or footage from lines C. NW $\frac{1}{2}$ NE $\frac{1}{2}$

Lease Owner Black-Marshall Oil Company

Lease Name Ney Well No. 2

Office Address P. O. Box 6, Great Bend, Kansas

Character of Well (completed as Oil, Gas or Dry Hole) Dry Hole

Date well completed October 26 19 42

Application for plugging filed October 26 19 42

Application for plugging approved October 28, 19 42

Plugging commenced October 28, 19 42

Plugging completed October 28, 19 42

Reason for abandonment of well or producing formation Dry Hole

If a producing well is abandoned, date of last production 19

Was permission obtained from the Conservation Division or its agents before plugging was commenced? Yes

Name of Conservation Agent who supervised plugging of this well C. T. Alexander

Producing formation Depth to top Bottom Total Depth of Well 3335 Feet

Show depth and thickness of all water, oil and gas formations.

OIL, GAS OR WATER RECORDS

CASING RECORD

Formation	Content	From	To	Size	Put In	Pulled Out
Shale	H.F. water	350	415	12 $\frac{1}{2}$ "	412	412
Anhydrite	H.F. water	710	714	10"	714	714
Lime	2B.W. water	2423	2430	8 $\frac{1}{2}$ "	2429	2429
Lime	H.F. water	3067	3106	7"	3104	3104

Describe in detail the manner in which the well was plugged, indicating where the mud fluid was placed and the method or methods used in introducing it into the hold. If cement or other plugs were used, state the character of same and depth placed, from feet to feet for each plug set.

Cemented with 6 sacks of cement with dump bailer and mudded to 305 using sand line and oil drum to dump in hole. Bridged hole with wood plug and rock 305 and cemented with dump bailer. Mudded to 18 feet bridged hole with wood plug and rock at 18 feet cemented from 18 feet to 8 feet

(If additional description is necessary, use BACK of this sheet)

Correspondence regarding this well should be addressed to Black-Marshall Oil Company, Address P. O. Box 6, Great Bend, Kansas

STATE OF Kansas, COUNTY OF Barton, ss.

Leon F. Huff (employee of owner) or (owner or operator) of the above-described well, being first duly sworn on oath, says: That I have knowledge of the facts, statements, and matters herein contained and the log of the above-described well as filed and that the same are true and correct. So help me God.


Black-Marshall Oil Company
(Signature) Leon F. Huff Asst. Secy. & Treas.

Ruth Brown, Notary Public

SUBSCRIBED AND SWORN TO before me this 6th day of November, 19 42

My commission expires May 22, 1943

Notary Public.

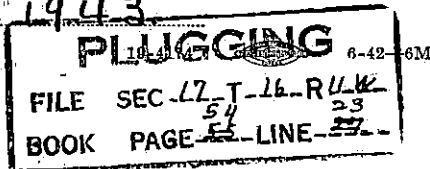

15009-06488-0000

BLACK-MARSHALL OIL COMPANY

#2 Ney 17-16S-11W Barton County, Kansas
(CNW $\frac{1}{4}$ NB $\frac{1}{4}$)

Commenced Rigging up	9-2-42	12 $\frac{1}{2}$ "	412'
Completed Rigging up	9-16-42	10"	714'
Commenced Drilling	9-16-42	8 $\frac{1}{4}$ "	2429'
Completed Drilling	10-26-42	7"	3104'

Elevation 1857

Cellar	0	10		Lime	1965	1975	
Post Rock	10	15		Red Rock	1975	1995	
Yellow clay	15	20		Lime	1995	2015	
Blue shale	20	100		Shale	2015	2020	
Blue mud	100	145		Shale blue	2020	2030	
Sand	145	155		Lime & Shale	2030	2050	
Shale	155	190		Shale & Shells	2050	2065	
Red Rock	190	205		Shale	2065	2080	
Sand	205	215		Lime	2080	2090	3B.W. 2085'
Red Rock	215	240	8 B.W. 210'	Shale	2090	2110	
Shale blue	240	265		Sandy Shale	2110	2130	
Sand	265	275		Shale	2130	2135	
Sand	275	280		Lime	2135	2150	
Red Rock	280	320		Shale	2150	2165	
Shale	320	330	H.F.W. 330'	Lime	2165	2180	
Sand	330	350		Shale	2180	2210	
Shale Blue	350	400		Shale blue	2210	2235	
Shale	400	415		Lime	2235	2265	
Sand	415	425	H.F.W. 420'	Shale	2265	2290	
Shale	425	430		Lime	2290	2295	
Shale Blue	430	440		Shale	2295	2310	
Sand	440	455		Shale blue	2310	2360	
Shale blue	445	495		Shale	2360	2365	
Red Rock	495	710		Lime	2365	2382	
Anhydrite	710	730		Shale	2382	2390	
Red Rock	730	925		Sandy shale	2390	2410	2B.W. 2390-2400'
Shale blue	925	970		Shale	2410	2423	
Red Rock	970	1050		Lime	2423	2432	
Shale blue	1050	1120		Shale	2432	2440	
Shale	1120	1135		Lime	2440	2450	
Salt	1135	1150		Shale	2450	2465	
Shale	1150	1155		Lime	2465	2475	
Salt	1155	1335		Shale	2475	2485	
Shale	1335	1375		Lime	2485	2505	
Shale & shells	1375	1435		Shale blue	2505	2555	
Lime	1435	1450		Shale & Shells	2555	2580	
Shale blue	1450	1460		Shale	2580	2595	
Shale & Shells	1460	1500		Lime	2595	2615	
Red Rock	1500	1510		Shale	2615	2620	
Shale & Shells	1510	1525		Lime	2620	2630	
Shale sandy	1525	1615		Shale	2630	2635	
Red Rock	1615	1630		Lime	2635	2783	
Lime broken	1630	1750	1 $\frac{1}{2}$ B.W. 1700'	Shale blue	2783	2789	
Lime	1750	1760	1 B.W. 1750'	Lime	2789	2887	
Sandy shale	1760	1780		Shale black	2887	2890	
Shale blue	1780	1790		Lime	2890	2894	
Lime	1790	1800		Shale blue	2894	2905	2 B.W. 2900'
Shale blue	1800	1810		Lime	2905	2915	
Lime	1810	1830		Red Rock	2915	2920	
Shale	1830	1835		Shale Blue	2920	2930	
Shale	1835	1855		Sandy shale	2930	2955	
Red Rock	1855	1865		Red Rock	2955	2960	
Lime Shells & Shale	1865	1875		Shale	2960	2980	
Shale	1875	1885		Lime	2980	2985	
Lime	1885	1895		Shale	2985	2997	
Red Rock	1895	1925		Lime	2997	3034	
Shale	1925	1940		Red Rock & Shale	3034	3040	
Lime	1940	1945		Lime	3040	3060	
Shale	1945	1955		Sandy Lime	3060	3064	
Shale blue	1955	1965		Shale	3064	3067	

15-09-06488-0000

BLACK-MARSHALL OIL COMPANY

#2 NEY 17-16S-11W Barton County, Kansas

Page 2 Continued

Lime	3067	3070	
Lime	3070	3080	
Lime soft	3080	3100	H.F.W. 3080-85'
Lime	3100	3140	1 1/2 B.W. 3110-20'
Shale black	3140	3142	
Lime light	3142	3150	
Lime	3150	3185	
Shale	3185	3190	
Lime	3190	3204	
Shale Blue	3204	3210	
Lime	3210	3250	
Shale	3250	3254	
Lime	3254	3272	
Shale	3272	3276	
Lime broken	3276	3280	
Lime & Red Rock	3280	3290	
Red Rock	3290	3292	
Conglomerate	3292	3323	
Siliceous	3323	3335	

STATE OF KANSAS)
COUNTY OF BARTON) SS

I hereby certify that the above is a true and correct record of the formations penetrated in the drilling of the Ney #2 well located in the CNW 1/4 NE 1/4 of Sec. 17-16S-11W, Barton County, Kansas.

Leon F. Huff
Leon F. Huff

Subscribed and sworn to before me this 6th day of November, 1942.

Ruth Brauer

My commission expires:
May 22 - 1943.

PLUGGING
FILE SEC-17-16-R11W
BOOK PAGE 23 LINE 23