


WELL PLUGGING RECORD

Give All Information Completely
Make Required Affidavit
Mail or Deliver Report to:
Conservation Division
State Corporation Commission
211 No. Broadway
Wichita, Kansas

NORTH

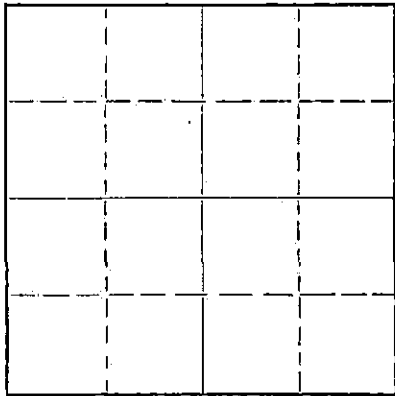

Locate well correctly on above
Section Flat

Stafford County, Sec. 1 Twp. 24S Rge. 14W (W)

Location as "NE/CNW/SW" or footage from lines SE SE NE

Lease Owner D.R. Lauck Oil Company, Inc.

Lease Name Vanhoozer Well No. 1

Office Address Wichita, Kansas

Character of Well (completed as Oil, Gas or Dry Hole) dry hole

Date well completed January 27, 19 57

Application for plugging filed January 27, 19 57

Application for plugging approved January 27, 19 57

Plugging commenced January 27, 19 57

Plugging completed January 27, 19 57

Reason for abandonment of well or producing formation

dry hole

If a producing well is abandoned, date of last production -- 19

Was permission obtained from the Conservation Division or its agents before plugging was commenced? yes

Name of Conservation Agent who supervised plugging of this well Mr. R. M. Brundage

Producing formation -- Depth to top -- Bottom -- Total Depth of Well 4132 Feet

Show depth and thickness of all water, oil and gas formations.

OIL, GAS OR WATER RECORDS

CASING RECORD

FORMATION	CONTENT	FROM	TO	SIZE	PUT IN	PULLED OUT
		0	210	8 5/8"	210'	none

Describe in detail the manner in which the well was plugged, indicating where the mud fluid was placed and the method or methods used in introducing it into the hole. If cement or other plugs were used, state the character of same and depth placed, from feet to feet for each plug set.

hole filled with mud 4132-180
 plug 180-176
 cement 176-136
 mud 136- 35
 plug 35- 31
 cement 31- 6' bottom of cellar

RECEIVED
STATE CORPORATION COMMISSION

FEB 2 1957

CONSERVATION DIVISION
Wichita, Kansas

2-2-57

(If additional description is necessary, use BACK of this sheet)

Name of Plugging Contractor

Address

STATE OF Kansas, COUNTY OF Sedgwick, ss.

John H. Knightley (employee of owner) of the above-described well, being first duly sworn on oath, says: That I have knowledge of the facts, statements, and matters herein contained and the log of the above-described well as filed and that the same are true and correct. So help me God.

(Signature) John H. Knightley

Wichita, Kans
(Address)

SUBSCRIBED AND SWORN TO before me this 31 day of January, 19 57

My commission expires Sept. 14, 1959

Elizabeth Gay
Notary Public.

PLUGGING
FILE SEC 1 T 24 R 14W
BOOK PAGE 137 LINE 7

15-185.00557-0000

D. R. Lauck Oil Company, Inc.

Vanhoozer No.1

SE SE NE Sec.1-24S-14W
Stafford County, Kansas

Commenced: January 14, 1957
Completed: January 27, 1957

Casing Record: 210' 8 5/8" cemented with 200 sacks

Elevation: GR 1904; DF 1907; KB 1909;

Drillers Log

shale	15
sand	150
shale & shells	210
red bed & shale	585
sand & red bed	670
red bed & shells	800
Anhydrite	825
shale & shells	1650
shale & lime	2340
shale & shells	2540
shale & lime	3265
lime	3410
shale & lime	3560
lime	3820
lime & shale	3936
chert & lime	4036
cherty lime & sand	4073
sand	4075
shale & lime	4102
Arbuckle	4132
Rotary Total Depth	4132

	<u>Tops</u>	
	<u>Sample</u>	<u>Halliburton</u>
Heebner	3406-1497	3406-1497
Douglas	3444-1535	3444-1535
Brown Limest.	3543-1634	3544-1635
Lansing	3568-1659	3570-1661
Base KC	3824-1915	3826-1917
Conglomerate	3884-1975	3880-1971
Viola	3931-2022	3932-2023
Simpson Shle	4049-2140	4052-2143
Simpson sand	4062-2153	4054-2145
Arbuckle	4102-2193	4105-2196
Rotary T.D.	4132-2223	4134-2225
	D & A	

DST#1 (W) 3588-3643 open 1 hr; fair blow throughout; recovered 170 ft. muddy water; BHP 1170# in 20" FP 0-180#;

DST #2 (W) 3712-3740 open 1 hr. weak blow throughout; recovered 75' muddy water w/few specks oil; BHP 1280# in 20 min. FP 0-0#

DST #3 (Sun) 4063-4075 Open 30 min; weak blow 20 min; flushed tool, no help; recovered 15' mud. BHP 100# in 20 min.

RECEIVED
STATE CORPORATION COMMISSION

FEB - 2 1957
CONSERVATION DIVISION
Wichita, Kan

PLUGGING
FILE SEC. <u>1</u> T. <u>24</u> R. <u>14w</u>
BOOK PAGE <u>137</u> LINE <u>7</u>