


Give All Information Completely  
Make Required Affidavit  
Mail or Deliver Report to:  
Conservation Division  
State Corporation Commission  
800 Bittling Building  
Wichita, Kansas

WELL PLUGGING RECORD

NORTH

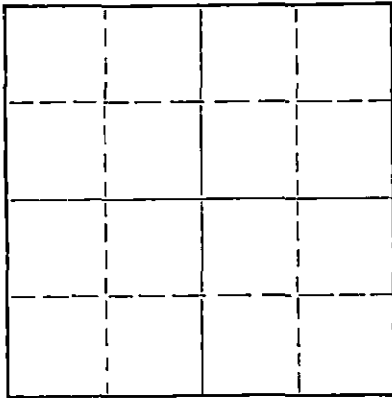

Locate well correctly on above  
Section Plat

Edwards

County. Sec. 11 Twp. 24 Rge. (E) 17 (W)

Location as "NE/CNW/SW" or footage from lines SE NW SW  
Lease Owner Iron Drilling Company  
Lease Name Enlow Well No. 1  
Office Address 1206 Philtower Building  
Character of Well (completed as Oil, Gas or Dry Hole) Dry Hole  
Date well completed 7/14/55 19  
Application for plugging filed 7/14/55 19  
Application for plugging approved K 7/14/55 19  
Plugging commenced 7/14/55 19  
Plugging completed 7/14/55 19  
Reason for abandonment of well or producing formation

If a producing well is abandoned, date of last production 19  
Was permission obtained from the Conservation Division or its agents before plugging was commenced? Yes

Name of Conservation Agent who supervised plugging of this well M. A. Rives  
Producing formation Depth to top Bottom Total Depth of Well 4690 Feet  
Show depth and thickness of all water, oil and gas formations.

OIL, GAS OR WATER RECORDS

CASING RECORD

FORMATION	CONTENT	FROM	TO	SIZE	PUT IN	PULLED OUT
Brown Lime		3854		8-5/8"	245	None
Kansas City		3864				
Simpson		4607				
Arbuckle		4690				

Describe in detail the manner in which the well was plugged, indicating where the mud fluid was placed and the method or methods used in introducing it into the hole. If cement or other plugs were used, state the character of same and depth placed, from \_\_\_\_\_ feet to \_\_\_\_\_ feet for each plug set.

Filled hole with heavy mud to 200 feet, set cement plug  
of 20 sacks of cement 1/3 sack of hulls.  
Top plug set at 35' w/ 10 sacks of cement and 1/3 sack of hulls  
Cement to top of hole

(If additional description is necessary, use BACK of this sheet)

Name of Plugging Contractor Iron Drilling Company -  
Address 1206 Philtower Building, Tulsa, Okla.

STATE OF Oklahoma, COUNTY OF Tulsa, ss.  
J. L. Stackpole (employee of owner) or (owner or operator) of the above-described well, being first duly sworn on oath, says: That I have knowledge of the facts, statements, and matters herein contained and the log of the above-described well as filed and that the same are true and correct. So help me God.

(Signature) IRON DRILLING COMPANY  
J. L. Stackpole (Address)

SUBSCRIBED AND SWORN TO before me this XX 27 day of July, 19 55

B. Michal

My commission expires February 28, 1956

Notary Public.

PLUGGING  
SEC. 11 T. 24 R. 17 W  
BOOK PAGE 135 LINE 34

RECEIVED  
STATE CORPORATION COMMISSION  
JUL 29 1955  
7-29-55  
CONSERVATION DIVISION  
Wichita, Kansas

IRON DRILLING COMPANY  
1206 Philtower Building  
Tulsa, Okla.

DRILLING RECORD

Well #1 Enlow  
SE NW SW Sec. 11-24S-17W  
Edwards County, Kansas

Casing Record

245' - 8-5/8" OD LW Casing  
cemented w/150 sacks cement

Well Commenced 6/28/55  
Drilling Commenced 6/29/55  
Drilling Completed 7/15/55  
Well Completed 7/15/55

Well Log

Surface soil	0	to	70
Shale & shells	70	to	245
Shale & Shells	245	to	875
Shale	875	to	1220
Red Beds	1220	to	1250
Shale & Shells	1250	to	1800
Anhydrite	1800	to	1834
Shale & Shells	1834	to	2105
Shale & Lime	2105	to	2240
Shale & Shells	2240	to	2280
Shale & Lime	2280	to	3893
Lime	3893	to	4196
Lime & Shale	4196	to	4296
Lime	4296	to	4356
Lime & Shale	4356	to	4435
Lime	4435	to	4527
Chert & Shale	4527	to	4575
Lime & Shale	4575	to	4590
Simpson	4590	to	4614
Shale & Lime	4614	to	4645
Lime	4645	to	4690

**PLUGGING**  
FILE SEC 11 T 24 R 17W  
BOOK PAGE 135 LINE 34


Tulsa, Oklahoma