


STATE OF KANSAS
STATE CORPORATION COMMISSION

WELL PLUGGING RECORD

Give All Information Completely
Make Required Affidavit
Mail or Deliver Report to
Conservation Division
State Corporation Comm.
245 North Water
Wichita, KS 67202

Hamilton County. Sec. 20 Twp. 24S Rge. 40W E/W
Location as NE/CNW 1/4 SW 1/4 or footage from lines
W/2 NET 4 SW NE NE KCAF 2-1406
Lease Owner Dome Petroleum Corp.
Lease Name Johnston Well No. 1
Office Address Box 1047 Syracuse, Kansas 67878
Character of Well (Completed as Oil, Gas or Dry Hole) _____

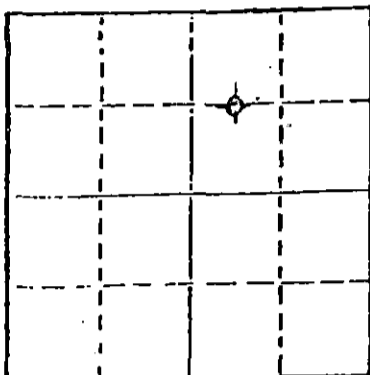

Locate well correctly on above
Section Plat

Gas
Date Well completed _____ 19____
Application for plugging filed _____ 19____
Application for plugging approved _____ 12-8 _____ 1980
Plugging commenced _____ 12-16 _____ 1980
Plugging completed _____ 12-16 _____ 1980
Reason for abandonment of well or producing formation _____

Non Commercial value
If a producing well is abandoned, date of last production _____ 19____

Was permission obtained from the Conservation Division or its agents before plugging was commenced? Yes

Name of Conservation Agent who supervised plugging of this well Mr. Dekey
Producing formation Winfield Depth to top 2318 Bottom 2329 Total Depth of Well 2425
Show depth and thickness of all water, oil and gas formations.

OIL, GAS OR WATER RECORDS

CASING RECORD

FORMATION	CONTENT	FROM	TO	SIZE	PUT IN	PULLED OUT
Surface				8-5/8"	323'	0
Production				4.5"	2425	0

Describe in detail the manner in which the well was plugged, indicating where the mud fluid was placed and the method or methods used in introducing it into the hold. If cement or other plugs were used, state the character of same and depth placed, from _____ feet to _____ feet for each plug set.

12-16-80 Pumped 2 sx. hulls and 50 sx. cement. Displaced to bottom with 9#/gal, gelled water followed by 10 sx. cement for top plug. Pressured up to 500#. Cut off 8-5/8" & 4 1/2" casings 48" below ground level.

(If additional description is necessary, use BACK of this sheet)

Name of Plugging Contractor Halliburton Lamar, Colo.

STATE OF Colorado COUNTY OF Denver, ss.
Jerry Anderson (employee of owner) or (owner or operator)
of the above-described well, being first duly sworn on oath, says: That I have knowledge of the facts, statements, and matters herein contained and the log of the above-described well as filed and that the same are true and correct. So help me God.

(Signature) Jerry Anderson
1625 Broadway D Ste 2900 Denver, Co. 80202
(Address)

SUBSCRIBED AND SWORN TO before me this 22nd day of January, 1981

My commission expires August 14, 1981

[Signature]
Notary Public.

FEB - 5 1981
2-5-81
CONSERVATION DIVISION
Wichita, Kansas



ACOUSTIC VELOCITY GAMMA CALIPER LOG

15-075-26160-0000

COMPANY COMPUTER PETROLEUM EXPLORATION Co.
 WELL Johnson #1
 FIELD BRADSHAW
 COUNTY HAMILTON STATE KANSAS
 Location W/2 NE/4 Other Services: F/F
 Sec. 20 Twp 24S Rge 40W
 Permanent Datum G.L. Elev. EST. 3235' Elev.: K.B. EST. 3243'
 Log Measured From K.B. 8' Ft. Above Perm. Datum D.F. —
 Drilling Measured From K.B. G.L. EST. 3235'

Date	<u>10-10-76</u>			
Run No.	<u>ONE</u>			
Depth—Driller	<u>2425'</u>			
Depth—Welex	<u>2424'</u>			
Btm. Log Inter.	<u>2416'</u>			
Top Log Inter.	<u>323'</u>			
Casing—Driller	<u>3 7/8" @ 323'</u>	@	@	@
Casing—Welex	<u>323'</u>			
Bit Size	<u>7 7/8"</u>			
Type Fluid in Hole	<u>W.B. MUD</u> <u>CHEMICALS</u>			
Dens. Visc.	— —			
pH Fluid Loss	— — ml	ml	ml	ml
Source of Sample	<u>—</u>			
R _m @ Meas. Temp.	— @ — °F	@ °F	@ °F	@ °F
R _{mt} @ Meas. Temp.	— @ — °F	@ °F	@ °F	@ °F
R _{mc} @ Meas. Temp.	— @ — °F	@ °F	@ °F	@ °F
Source R _{mt} R _{mc}	— —			
R _m @ BHT	— @ — °F	@ °F	@ °F	@ °F
Time Since Circ.	<u>—</u>			
Max. Rec. Temp.	— °F @ —	°F @	°F @	°F @
Equip. Location	<u>9689121B</u>			
Recorded By	<u>F. MITCHELL & J. ARMSTRONG</u>			
Witnessed By	<u>MR. BOB HIGGINS BOTTOM</u>			

