


STATE OF KANSAS
STATE CORPORATION COMMISSION

WELL PLUGGING RECORD

Give All Information Completely
Make Required Affidavit
Mail or Deliver Report to
Conservation Division
State Corporation Comm.
245 North Water
Wichita, KS 67202

Hamilton County, Sec. 35 Twp. 24 Rge. 40 E/W
Location as "NE/CNW 1/4 SW 1/4" or footage from lines

Lease Owner G. J. NW
Lease Name Petromark Well No. 1
Office Address 4606 E. 67th Tulsa, Okla. 74177
Character of Well (Completed as Oil, Gas or Dry Hole) Dry Hole

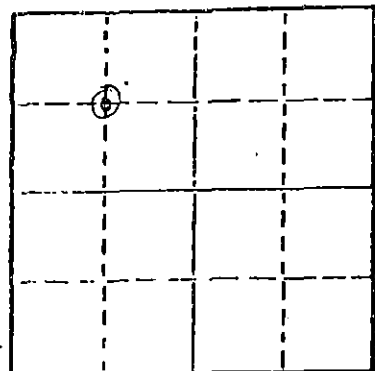

Date Well completed 11-28 1981
Application for plugging filed 11-28 1981
Application for plugging approved 11-28 1981
Plugging commenced 5:00 A.M. 11-28 1981
Plugging completed 9:30 A.M. 11-28 1981
Reason for abandonment of well or producing formation Dry Hole

If a producing well is abandoned, date of last production 19

Was permission obtained from the Conservation Division or its agents before plugging was commenced? Yes

Name of Conservation Agent who supervised plugging of this well Tommy Thomas Garden City, Kansas
Producing formation Winfield Depth to top Bottom Total Depth of Well 2400'
Show depth and thickness of all water, oil and gas formations.

OIL, GAS OR WATER RECORDS

CASING RECORD

FORMATION	CONTENT	FROM	TO	SIZE	PUT IN	PULLED OUT
Surface			366'	8 5/8"	X	Left

Describe in detail the manner in which the well was plugged, indicating where the mud fluid was placed and the method or methods used in introducing it into the hold. If cement or other plugs were used, state the character of same and depth placed, from feet to feet for each plug set.

Dry Hole:
Plug with 50 Sx. @ 1245'
40 Sx. @ 340'
10 Sx. 40' to 0
5 Sx. Rathole
Job done by Dowell-Completed @ 9:30 A.M. 11-28-81

(If additional description is necessary, use BACK of this sheet)


Name of Plugging Contractor Dowell Chemical

STATE OF KANSAS COUNTY OF SEWARD, ss.
R. L. Higginbottom, agent (employee of owner) or (owner or operator)
of the above-described well, being first duly sworn on oath, says: That I have knowledge of the facts, statements, and matters herein contained and the log of the above-described well as filed and that the same are true and correct. So help me God.

(Signature) R. L. Higginbottom
Box 6; Liberal, KS 67901
(Address)

SUBSCRIBED AND SWORN TO before me this 15th day of December, 1981

My commission expires

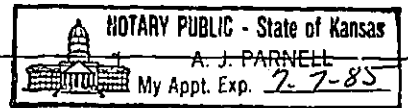

RECEIVED
STATE CORPORATION COMMISSION
Notary Public.
DEC 16 1981

CONSERVATION DIVISION
Wichita, Kansas
12-16-81

