


STATE OF KANSAS
STATE CORPORATION COMMISSION

WELL PLUGGING RECORD

Give All Information Completely
Make Required Affidavit
Mail or Deliver Report to:
Conservation Division
State Corporation Commission
212 North Market, Insurance Bldg.
Wichita, Kansas

Hamilton County, Sec. 5 Twp. 24S Rge. 41 (E) X (W)
C-SW-NE

NORTH

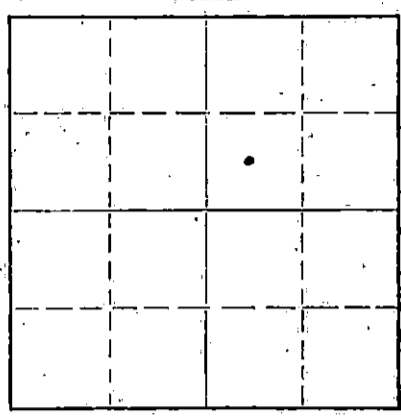

Locate well correctly on above Section Plat

Location as "NE/CNW/SW" or footage from lines _____
Lease Owner Livingston Oil Co.
Lease Name (Owings 1-15) Well No. 0541
Office Address Box 610 Syracuse, Kansas.
Character of Well (completed as Oil, Gas or Dry Hole) Dry.
Date well completed 11-4- 19 62
Application for plugging filed 8-2- 19 65
Application for plugging approved 8-3- 19 65
Plugging commenced 10-25- 19 65
Plugging completed 10-25- 19 65
Reason for abandonment of well or producing formation Made too much water.

If a producing well is abandoned, date of last production _____ 19 _____
Was permission obtained from the Conservation Division or its agents before plugging was commenced? Yes.

Name of Conservation Agent who supervised plugging of this well Hugh Scott.
Producing formation Winfield Krider. Depth to top 225 Bottom 2298 Total Depth of Well 2315 Feet
Show depth and thickness of all water, oil and gas formations.

OIL, GAS OR WATER RECORDS

CASING RECORD

FORMATION	CONTENT	FROM	TO	SIZE	PUT IN	PULLED OUT
				8-5/8"		None.
				4-1/2"		None.

Describe in detail the manner in which the well was plugged, indicating where the mud fluid was placed and the method or methods used in introducing it into the hole. If cement or other plugs were used, state the character of same and depth placed, from _____ feet to _____ feet for each plug set.

Mix 20 sacks cement to plug off perforation and stop plug at 2000 ft. Fill with mud to 700 feet and pump 10 sacks cement at 700 feet to 600 feet. Fill with mud to 60 feet and put 5 sacks cement at 60 feet to -0- feet. Cut 8-5/8" off 3 feet below ground level and cap same.

RECEIVED
STATE CORPORATION COMMISSION

DEC - 3 1965

CONSERVATION DIVISION
Wichita, Kansas

12-3-65

(If additional description is necessary, use BACK of this sheet)
Name of Plugging Contractor Sargents Casing Pulling Service.
Address Box 506. Liberal, Kansas.

STATE OF OKLAHOMA COUNTY OF TULSA, ss.
James A. Townsend (employee of owner) or (owner/lessee/operator) of the above-described well, being first duly sworn on oath, says: That I have knowledge of the facts, statements, and matters herein contained and the log of the above-described well as filed and that the same are true and correct. So help me God.

(Signature) James A. Townsend
Chief Production Clerk
Box 1797, Tulsa, Oklahoma
(Address)

SUBSCRIBED AND SWORN to before me this 1 day of December, 19 65

Margaret Heath
Notary Public.

My commission expires 8-10-69

054

15.075-00028-0000

HAMILTON BROTHERS, INC.
UNIT 0541
Owing Well No. 1-15
Hamilton County, Kansas

Commenced Operations: 6-18-60
Completed Operations: 6-23-60

RECEIVED
STATE CORPORATION COMMISSION

AUG 3 - 1963

DRILLERS LOG

0 - 350	Sand and Gravel
350 - 650	Blue Shale
650 - 1070	Red Bed and Shale
1070 - 2244	Shale and Anhydrite
2244 - 2315	Sand and Shale
2315	Total Depth

CONSERVATION DIVISION
Wichita, Kansas

CASING RECORD

6-19-60	Ran 13 jts of 8 5/8" - 24# Casing set at 397.66' (G.L.). Cemented with 225 sacks common, 3% c.c.
6-23-60	Ran 74 jts of 4 1/2" - 9.5# casing set at 2317.65 (K.D.B.). Cemented with 500 sacks common, 8% gel.