

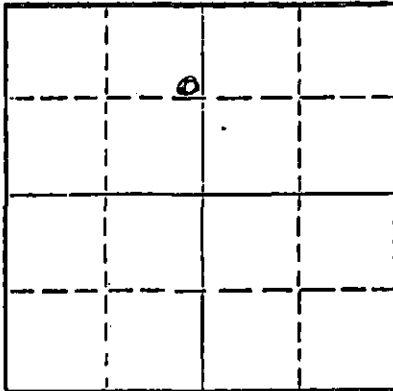
STATE OF KANSAS
STATE CORPORATION COMMISSION

Form CP-4

Give All Information Completely
Make Required Affidavit
Mail or Deliver Report to:
Conservation Division
State Corporation Commission
211 No. Broadway
Wichita, Kansas

WELL PLUGGING RECORD

NORTH

Locate well correctly on above
Section Plat

Hamilton County, Sec. 6 Twp. 24S Rge. (E) 41W (W)
Location as "NE/CNW/SW" or footage from lines 1226' FNL & 2690' FEL
Lease Owner Anadarko Production Company
Lease Name Milsap "A" Well No. 1
Office Address Box 351 Liberal, Kansas
Character of Well (completed as Oil, Gas or Dry Hole) Gas
Date well completed 12-15 1964
Application for plugging filed 8-23 1965
Application for plugging approved 8-26 1965
Plugging commenced 9-22 1965
Plugging completed 9-22 1965
Reason for abandonment of well or producing formation
None economical
If a producing well is abandoned, date of last production None 19
Was permission obtained from the Conservation Division or its agents before plugging was commenced? Yes

Name of Conservation Agent who supervised plugging of this well Hugh E. Scott, Sublett, Kansas
Producing formation Winfield Depth to top 2284 Bottom 2284 Total Depth of Well 2304 Feet
Show depth and thickness of all water, oil and gas formations.

OIL, GAS OR WATER RECORDS

CASING RECORD

FORMATION	CONTENT	FROM	TO	SIZE	PUT IN	PULLED OUT
Winfield	Gas		2284	10 3/4 4 1/2	66' 2302	None

Describe in detail the manner in which the well was plugged, indicating where the mud fluid was placed and the method or methods used in introducing it into the hole. If cement or other plugs were used, state the character of same and depth placed, from feet to feet for each plug set.

Pulled 1 1/4" Tubing & 1/2" Sucker rods.
Spotted 10 sxs cement. Pumped plug to 2100'. Filled hole with mud to 700'.
Spotted 10 sxs cement from 700' - 600'. Filled hole with mud from 600' - 54'.
Spotted 5 sxs cement from 54' - 4' below surface. Pumped 5 sxs cement in 2" tubing disposal string. Complete @ 1:00 PM 9-22-65.

RECEIVED
STATE CORPORATION COMMISSION

SEP 30 1965

RECEIVED
STATE CORPORATION COMMISSION

SEP 28 1965

CONSERVATION DIVISION
WICHITA, KANSAS

(If additional description is necessary, use BACK of this sheet)
Name of Plugging Contractor Sargent's Casing Pulling Service
Address 1546 Clay Courts Liberal, Kansas

STATE OF Kansas, COUNTY OF Seward, ss.
V. K. Downey

(employee of owner) or (owner or operator) of the above-described well, being first duly sworn on oath, says: That I have knowledge of the facts, statements, and matters herein contained and the log of the above-described well as filed and that the same are true and correct. So help me God.

(Signature)

V. K. Downey Division Superintendent Drilling & Production
Box 351 Liberal, Kansas
(Address)

SUBSCRIBED AND SWORN TO before me this 29th day of September, 1965.

My commission expires
My Commission Expires Sept. 29, 1968

Donald L. Vangieson

Notary Public.

DRILLER'S LOG

WELL NAME: Millsap "A" No. 1; COMPANY OPERATING: Anadarko Production Company
 ADDRESS of COMPANY: Box 351, Liberal, Kansas
 WELL LOCATION: $\frac{1}{4}$ $\frac{1}{4}$ $\frac{1}{4}$,
1226 ft. ~~North of South line~~, south of north line,
2690 ft. ~~East of West line~~; Sec. 6, Twp. 24S, Rge. 41W, Hamilton County, Kansas
 west of east line
 DRILLING STARTED 11-25, 19 64; DRILLING COMPLETED 11-29, 19 64
 WELL COMPLETED 12-15, 19 64; WELL CONNECTED _____, 19 _____
 ELEVATION: 3272.85 ft. Ground Level; CHARACTER OF WELL (Oil, Gas, or Dry Hole) Gas

OIL OR GAS SANDS OR ZONES - PERFORATIONS - ACIDIZING AND FRACTURING INFORMATION					
Name	From	To	No. of Shots	Gallons Used	Kind Used
Winfield	2284		4	15,000	3% Acid

CASING RECORD

Size	Amount Set	Sacks of Cement	Amount Pulled
10-3/4	661	600	
4-1/2	2302	125	

FORMATION RECORD

Formation	Top	Bottom	Formation	Top	Bottom
Surface sand & clay	0	400			
Shale & shells	400	630			
Red bed	630	1450			
Red bed & shale	1450	1778			
Anhydrite	1778	1797			
Red bed & shale	1797	1820			
Shale	1820	2075			
Shale & lime	2075	2180			
Lime	2180	2304			
Total Depth	2304				

RECEIVED
 STATE CORPORATION COMMISSION

SEP 30 1965

CONSERVATION DIVISION
 Wichita, Kansas

RESULTS of INITIAL PRODUCTION TEST: 1788 MCFD on 24-Hour Blowdown.