

15.167.20690.00.00


STATE OF KANSAS
STATE CORPORATION COMMISSION
CONSERVATION DIVISION
P. O. BOX 17027
WICHITA, KANSAS 67217

FORM CP-4

WELL PLUGGING RECORD

Russell County, Sec. 29 Twp. 14 Rge. (E) 12 (W)

Location as "NE/CNW/SW" or footage from lines NW NE SE
Lease Owner J. L. King Oil Operations
Lease Name Henry J. Kepka Well No. 1
Office Address Drawer 73, Russell, Kansas 67665
Character of Well (completed as Oil, Gas or Dry Hole) oil
Date well completed Sept. 25 19 74
Application for plugging filed Oct. 30 19 74
Application for plugging approved 19
Plugging commenced Nov. 4 19 74
Plugging completed Nov. 7 19 74
Reason for abandonment of well or producing formation depleted

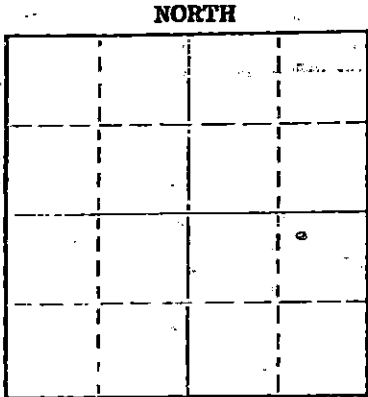

Locate well correctly on above Section Plat

If a producing well is abandoned, date of last production 19
Was permission obtained from the Conservation Division or its agents before plugging was commenced? yes

Name of Conservation Agent who supervised plugging of this well Donald Truan
Producing formation _____ Depth to top _____ Bottom _____ Total Depth of Well 3180 Feet
Show depth and thickness of all water, oil and gas formations.

OIL, GAS OR WATER RECORDS

CASING RECORD

FORMATION	CONTENT	FROM	TO	SIZE	PUT IN	PULLED OUT
			615'	8 5/8"	615'	none
			3179'	5 1/2"	3179'	2030.15

Describe in detail the manner in which the well was plugged, indicating where the mud fluid was placed and the method or methods used in introducing it into the hole. If cement or other plugs were used, state the character of same and depth placed, from _____ feet to _____ feet for each plug set.

Sanded back to 2140' and dumped 5 sacks of cement.
Set 20' rock bridge at 350' and plugged well with 5 yards of ready mix cement.

RECEIVED
STATE CORPORATION COMMISSION

NOV 14 1974

Name of Plugging Contractor PIPE PULLERS, INC. (If additional description is necessary, use BACK of this sheet)
Address Box 128, Ellinwood, Kansas 67526 CONSERVATION DIVISION
Wichita, Kansas

STATE OF KANSAS COUNTY OF BARTON ss.
Evelyn Roth (employee of owner) or (owner or operator) of the above-described

well, being first duly sworn on oath, says: That I have knowledge of the facts, statements, and matters herein contained and the log of the above-described well as filed and that the same are true and correct. So help me God.

(Signature) Evelyn Roth
Ellinwood, Kansas
(Address)

SUBSCRIBED AND SWORN TO before me this 13th day of November, 19 74

My commission expires
JENNY KASSELMAN
NOTARY PUBLIC
BARTON COUNTY, KANSAS
MY COMM. EXP. JULY 16, 1978

Jenny Kasselmann
Notary Public.

DRILLERS' LOG

No. 1 Kepka

CASING RECORD:

8-5/8" @ 615'
w/350 sx. cmt.

5-1/2" @ 3,179'
w/200 sx. cmt.

TOTAL DEPTH: 3,180'

COMPANY: J.L. King Oil Operations

CONTRACTOR: Red Tiger Drilling Co.

COMMENCED: September 17, 1974

COMPLETED: September 25, 1974

DESCRIPTION:

NW NE SE
29-14S-12W
Russell County,
Kansas

ELEVATION: 1,683' RB

<u>FORMATION</u>	<u>FROM</u>	<u>TO</u>	<u>REMARKS</u>
Surface Hole	0	130	
Shale, Sand, Redbed	130	595	
Redbed & Anhydrite	595	618	
Anhydrite	618	635	
Shale & Shells	635	965	
Shale	965	1365	
Shale & Lime	1365	1625	
Lime & Shale	1625	1895	
Shale & Lime	1895	2595	
Lime & Shale	2595	2890	
Lime	2890	3050	
Lime & Shale	3050	3180	

RECEIVED
STATE CORPORATION COMMISSION
OCT 31 1974
CONSERVATION DIVISION
Wichita, Kansas

I certify that this is a true and correct copy of the above log to the best of my knowledge.

RED TIGER DRILLING COMPANY

Linda H. Dickens
Linda H. Dickens

Subscribed and sworn to before me this 1st day of October, 1974.

Diann Drennan
Notary Public

My Commission Expires:

December 28, 1977

