

Locate well correctly on above Section Plat

Russell County. Sec. 17 Twp. 14S Rge. 12W (XX) (W)
Location as "NE/CNW/SW" or footage from lines NE/4 NE/4 NW/4
Lease Owner Walters Drilling Co., et al
Lease Name Fritschen Well No. 1
Office Address 510 Orpheum Building, Wichita 2, Kansas
Character of Well (completed as Oil, Gas, or Dry Hole) Dry Hole
Date well completed November 8, 1954
Application for plugging filed (verbal) November 8, 1954
Application for plugging approved (verbal) November 8, 1954
Plugging commenced November 8, 1954
Plugging completed November 8, 1954

Reason for abandonment of well or producing formation Dry Hole
If a producing well is abandoned, date of last production 1954
Was permission obtained from the Conservation Division or its agents before plugging was commenced? Yes

Name of Conservation Agent who supervised plugging of this well ~~Stacy C. ...~~ Warren H. Horner
Producing formation None Depth to top Bottom Total Depth of Well 2406 Feet
Show depth and thickness of all water, oil and gas formations.

OIL, GAS OR WATER RECORDS

CASING RECORD

FORMATION	CONTENT	FROM	TO	SIZE	PUT IN	PULLED OUT
<u>None</u>	<u>None</u>	<u>0</u>	<u>164'</u>	<u>8 5/8"</u>	<u>164'</u>	<u>None</u>
<u>(No oil string run - dry and abandoned)</u>						

Describe in detail the manner in which the well was plugged, indicating where the mud fluid was placed and the method or methods used in introducing it into the hole. If cement or other plugs were used, state the character of same and depth placed, from feet to feet for each plug set.

Set bottom plug at 160' with 15 sacks cement and 1/3 sack Hulls.
Filled hole with heavy mud to 30'.
Set top plug at 30' with 10 sacks cement and 1/3 sack Hulls.

11-16-54

Name of Plugging Contractor Walters Drilling Co.
Address 510 Orpheum Building, Wichita 2, Kansas


STATE OF KANSAS COUNTY OF SEDGWICK, ss.
Russell I. Baker (employed or owner) of the above-described well, being first duly sworn on oath, says: That I have knowledge of the facts, statements, and matters here contained and the log of the above-described well as filed and that the same are true and correct. So help me God.

(Signature) Russell I. Baker
510 Orpheum Building, Wichita 2, Kansas
(Address)

Subscribed and sworn to before me this 9th day of November, 1954

My commission expires March 10, 1956.

Pauline ... Notary Public.

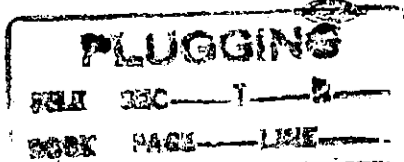

15. 167. 00185. 00. 00

FRITSCHEN NO. 1

Location: NE NE NW Sec. 17-14S-12W Date Spudded: 11-1-54
 Russell County, Kansas

Operator: Walters Drilling Co. Rotary completion: 11-8-54

Contractor: Walters Drilling Co. Elevation: 1773 Gr
 1775 DF
 1778 KB

Surface Casing: 8 5/8" set at 164' with
 100 sacks cement and 1
 Cal. Chloride

Oil String: None. D & A

L O G

(Figures indicate bottom of formation)

Surface	0 to 164
Shale	325
Sand and Shale	435
Shale	693
Anhydrite	731
Shale and Shells	1375
Lime and Shale	2406
Total Depth	2406

The undersigned, Russell I. Baker, hereby certifies that the above log is a true and correct log of the formations encountered in drilling the above noted well as reflected by the Daily Drilling Reports.

WALTERS DRILLING CO.

By Russell I. Baker

Subscribed and sworn to before me
this 9th day of November, 1954

Pauline Rudolph
Notary Public

My commission expires:
March 10, 1956

RECEIVED
 STATE COMMISSIONER OF GEOLOGY
 NOV 13 1954
 CONSERVATION DIVISION
 WASHINGTON

PLUGGING
 NE 1/4 SEC 17 T 14 S 12 W
 BOOK PAGE 26 LINE 43