

15. 167. 00374. 00. 00

WELL PLUGGING RECORD

STATE OF KANSAS STATE CORPORATION COMMISSION


Give All Information Completely Make Required Affidavit Mail or Deliver Report to: Conservation Division State Corporation Commission 800 Bittling Building Wichita, Kansas

OR

Strike out upper line when reporting plugging of formations.

FORMATION PLUGGING RECORD

Russell County. Sec. 21 Twp. 13 Rge. (E) 15 (W) Location as "NE 1/4 NW 1/4 SW 1/4" or footage from lines. NW NW NW Lease Owner JONES-SHELburne, INC. Lease Name Gorham Well No. 1 Office Address Oklahoma City, Oklahoma Character of Well (completed as Oil, Gas or Dry Hole) Dry Hole Date well completed 4/1/49 Application for plugging filed 4/2/49 Application for plugging approved 4/2/49 Plugging commenced 4/4/49 Plugging completed 4/11/49 Reason for abandonment of well or producing formation Dry Hole If a producing well is abandoned, date of last production 19 Was permission obtained from the Conservation Division or its agents before plugging was commenced? Yes

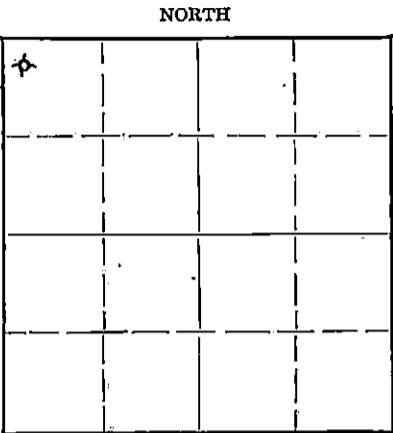

Locate well correctly on above Section Plat

Name of Conservation Agent who supervised plugging of this well Eldon Petty Producing formation None Depth to top Bottom Total Depth of Well 3297 Feet Show depth and thickness of all water, oil and gas formations.

OIL, GAS OR WATER RECORDS

CASING RECORD

Table with 7 columns: Formation, Content, From, To, Size, Put In, Pulled Out. Rows include SURFACE PIPE (8 inch, 212) and OIL STRING (5 inch, 3264, 2127).

Describe in detail the manner in which the well was plugged, indicating where the mud fluid was placed and the method or methods used in introducing it into the hole. If cement or other plugs were used, state the character of same and depth placed, from feet to feet for each plug set.

DUMPED 8 SACKS OF CEMENT ON TOP LANE-WELLS PACKER AT 3,050 FEET. CIRCULATED HOLE WITH HEAVY MUD THEN PULLED 2,127 FEET OF 5" PIPE. SET A PERMANENT ROCK BRIDGE TOP AT 200 FEET AND DUMPED 20 SACKS OF CEMENT ON TOP. FILLED HOLE TO 30 FEET OF TOP WITH HEAVY MUD. USED 10 SACKS CEMENT FOR CAP. 4-16-49

RECORDED

APR 16 1949


STATE CORPORATION COMMISSION KANSAS

Correspondence regarding this well should be addressed to JONES-SHELburne, INC. Address c/o State Capital Station, Oklahoma City, Oklahoma

STATE OF Kansas COUNTY OF Russell, ss. Ted Rutherford (employee of owner) or (owner or operator) of the above-described well, being first duly sworn on oath, says: That I have knowledge of the facts, statements, and matters herein contained and the log of the above-described well as filed and that the same are true and correct. So help me God.

(Signature) Ted Rutherford Russell, Kansas (Address)

SUBSCRIBED AND Sworn to before me this 14 day of April, 1949. My commission expires Oct 10-1950 Notary Public.

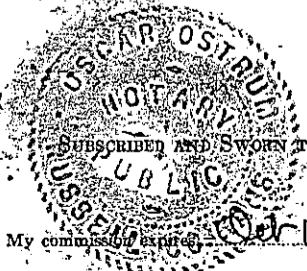

PLUGGING FILE SEC 21 T 13 R 15W BOOK PAGE 91 LINE 27

CONTRACTOR'S WELL LOG

Operator Jones-Shelburne, Inc. Farm Name #1 Gorham Estate

Location NW 3 Sec. 21-13-15W.

Pool Name WG County Russell State Kansas

Commencement Date February 3, 1949 Completion Date February 19, 1949

LOG OF WELL

Elevation 1835'

All measurements from the top of rotary casing.

DEPTH FROM	TO	FORMATION	DEVIATION FROM VERTICAL	REMARKS:
0	210	Post Rock-Shale-Sand		
210	515	Shale-Red Bed		
515	830	Red Bed-Shale		
830	880	Red Bed-Shale		
880	915	Anhydrite		
915	1210	Shale-Shells		
1210	1500	Shale-Shells		
1500	1560	Shale-Shells		
1560	1600	Lime		
1600	1750	Lime-Shale	1600' - 0°	
1750	1865	Lime		
1865	1905	Lime		
1905	1980	Lime		
1980	2045	Lime		
2045	2145	Lime-Shale	2100' - 0°	
2145	2220	Lime-Shale		
2220	2300	Shale-Lime		
2300	2410	Shale-Lime		
2410	2530	Lime-Shale		
2530	2610	Shale-Lime	2600' - 0°	
2610	2705	Shale-Lime		
2705	2765	Lime-Shale		
2765	2810	Lime		
2810	2843	Lime		
2843	2865	Lime		
2865	2918	Lime		
2918	2935	Lime		
2935	2975	Lime		
2975	3030	Lime		
3030	3065	Lime		
3065	3096	Lime		
3096	3145	Lime		
3145	3180	Lime		
3180	3230	Lime		
3230	3266	Lime-Shale		

CASING LEFT IN HOLE AFTER COMPLETION

212.96' (8-5/8" OD casing) 10 jts.

3270.10' (5-1/2" OD casing) 103 jts.

STATE OF KANSAS, COUNTY OF SEDGWICK ss.

The undersigned certifies that to the best of his knowledge and belief the above facts are true and correct.

C-G DRILLING COMPANY, Inc.
By *B.A. Cook*, President

Subscribed and sworn to before me this 23rd day of February, 1949.

My commission expires:
June 25, 1951

Wickly Fritz
Notary Public