


15.167.00131.00.00

WELL PLUGGING RECORD

Give All Information Completely
Make Required Affidavit
Mail or Deliver Report to:
Conservation Division
State Corporation Commission
800 Bittling Building
Wichita, Kansas

NORTH

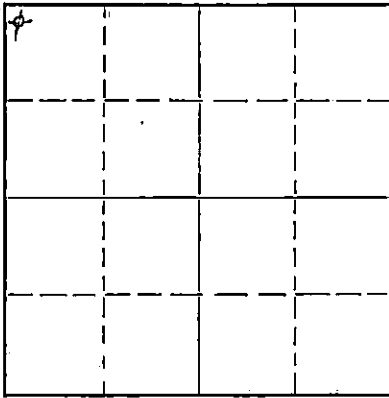

Locate well correctly on above Section Plat

Russell County. Sec. 18 Twp. 13 Rge. 15 1/2 (W)
Location as "NE/CNW 1/4 SW 1/4" or footage from lines NW NW NW
Lease Owner Fred J. Haynes
Lease Name Foster-Aley Well No. 1
Office Address Bldg. & Loan Bldg. Russell, Kansas
Character of Well (completed as Oil, Gas or Dry Hole) D. & A.
Date well completed 5-23-56 19.
Application for plugging filed 5-21-56 19.
Application for plugging approved 5-28-56 19.
Plugging commenced 5-23-56 19.
Plugging completed 5-23-56 19.
Reason for abandonment of well or producing formation

If a producing well is abandoned, date of last production 19.
Was permission obtained from the Conservation Division or its agents before plugging was commenced? Yes

Name of Conservation Agent who supervised plugging of this well Milton Galyardt, Box 145, Russell, Kansas
Producing formation Depth to top Bottom Total Depth of Well 3,369 Feet
Show depth and thickness of all water, oil and gas formations.

OIL, GAS OR WATER RECORDS

CASING RECORD

Formation	Content	From	To	Size	Put In	Pulled Out
				8 5/8"	195'	None

Describe in detail the manner in which the well was plugged, indicating where the mud fluid was placed and the method or methods used in introducing it into the hole. If cement or other plugs were used, state the character of same and depth placed, from feet to feet for each plug set.

Pump hole full of mud from 3,369 to 195 - set plug at 195 -
Cement with 20 sacks Cement and 1/2 sack hulls - fill with mud
to 40' - cement with 10 sacks cement and 1/2 sack hulls - Test
top plug for leak and found none.

6-6-58

STATE OF KANSAS

(If additional description is necessary, use BACK of this sheet)

Correspondence regarding this well should be addressed to Fred J. Haynes
Address Bldg. & Loan Bldg. Russell, Kansas

STATE OF Kansas, COUNTY OF Russell, ss.
Fred J. Haynes (employee of owner) or (owner or operator) of the above-described well,
being first duly sworn on oath, says: That I have knowledge of the facts, statements, and matters herein contained and the log of the above-described well as filed and that the same are true and correct. So help me God.

(Signature) Fred J. Haynes
Bldg. & Loan Bldg. Russell, Kansas
(Address)

SUBSCRIBED AND SWORN to before me this 5th day of June 1956
Notary Public.

My commission expires January 17, 1957.

PLUGGING
FILE SEC 18 T 13 R 150
BOOK PAGE 65 LINE 33