


Give All Information Completely
Make Required Affidavit
Mail or Deliver Report to:
Conservation Division
State Corporation Commission
800 Bittling Building
Wichita, Kansas

15.167.00247.00.00

WELL PLUGGING RECORD

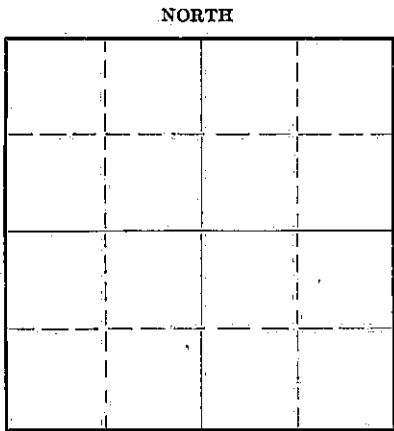

Locate well correctly on above Section Plat

Russell

County. Sec. 15 Twp. 13S Rge. 14 (E) W (W)

Location as "NE/CNW/SW" or footage from lines NE NE SE

Lease Owner B & R Drilling, Inc.

Lease Name Furthmeyer Well No. # 1

Office Address Russell, Kansas

Character of Well (completed as Oil, Gas or Dry Hole) Dry Hole

Date well completed January 24, 1950 19

Application for plugging filed January 23, 1950 Verbally 19

Application for plugging approved January 23, 1950 Verbally 19

Plugging commenced January 24, 1950 19

Plugging completed January 24, 1950 19

Reason for abandonment of well or producing formation Dry Hole

If a producing well is abandoned, date of last production 19

Was permission obtained from the Conservation Division or its agents before plugging was commenced? Yes

Name of Conservation Agent who supervised plugging of this well C. D. Stough

Producing formation: Depth to top Bottom Total Depth of Well 3340 Feet

Show depth and thickness of all water, oil and gas formations.

OIL, GAS OR WATER RECORDS

CASING RECORD

Formation	Content	From	To	Size	Put In	Pulled Out
				8 5/8"	180'	None

Describe in detail the manner in which the well was plugged, indicating where the mud fluid was placed and the method or methods used in introducing it into the hole. If cement or other plugs were used, state the character of same and depth placed, from feet to feet for each plug set.

Plugging Record

Fill hole with heavy mud to 180'. Plug @ 180'
15 Sacks cement through drill pipe. Fill hole
to 35' with heavy mud. Plug (tied to Surface
pipe) @ 35' 10 Sacks Cement.

JAN 28 1950 1-28-50

STATE CORPORATION
COMMISSION
KANSAS

(If additional description is necessary, use BACK of this sheet)

Correspondence regarding this well should be addressed to B & R DRILLING, INC.

Address RUSSELL, KANSAS

STATE OF KANSAS, COUNTY OF RUSSELL, ss.

DON ROBERTS (employee of owner) or (owner or operator) of the above-described well, being first duly sworn on oath, says: That I have knowledge of the facts, statements, and matters herein contained and the log of the above-described well as filed and that the same are true and correct. So help me God.

(Signature) Don Roberts


RUSSELL, KANSAS (Address)

SUBSCRIBED AND SWORN to before me this 26th day of JANUARY, 1950

Clara Hummel Notary Public.

6-17-50

My commission expires

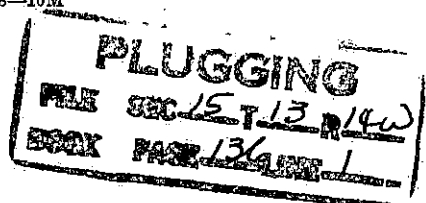

B & R DRILLING, INC.
FURTHMEYER #1

Sec. 15 Twp: 13S Rge: 14W
Russell, Kansas County

Total Depth: 3340'
Comm: 1/11/50
Comp: 1/24/50

Top: Heebner Sh. 2921
Top: Lansing K.C. 2978
Top: Cherty Congl 3268
Top: Arbuckle dd. 3310

Casing

Cement

8 5/8" Set @ 180'

130 Sacks

Formation	Depth:
Lime Stone	35
Rock-Shale	55
Shale-Shells	180
Shale	215
Shale-Red Bed	325
Iron Pyrite-Lime	340
Iron-Hard Sand	350
Iron	359
Shale-Shells	420
Sand	545
Shale-Shells	780
Red Bed-Shale-Shells	836
Anhydrite	858
Shale-Shells	1330
Shale-Salt	1450
Shale-Lime	2560
Shale	2630
Shale-Lime	2735
Shale-Lime-Pyrite	2793
Lime	2964
Lime-Shale	2978
Lime	3300
Conglomerate	3325
Arbuckle Lime	3340

STATE OF KANSAS)
) SS
RUSSELL COUNTY)

JAN 28 1950

I hereby certify that the above information is true and correct to the best of my knowledge.

Walter Zeller

Subscribed and sworn to before me this 26 th day of January, 1950.

Clara Sumner
Notary Public

My commission expires: 6-17-50

PLUGGING
FILE SEC-15 T-13 R-14
BOOK PAGE-36 UNIT-1