

STATE OF KANSAS
STATE CORPORATION COMMISSION


Give All Information Completely
Make Required Affidavit
Mail or Deliver Report to:
Conservation Division
State Corporation Commission
800 Bitting Building
Wichita, Kansas

15. 167. 00476. 00. 00
WELL PLUGGING RECORD

OR
FORMATION PLUGGING RECORD

Strike out upper line
when reporting plug-
ging off formations.

NORTH

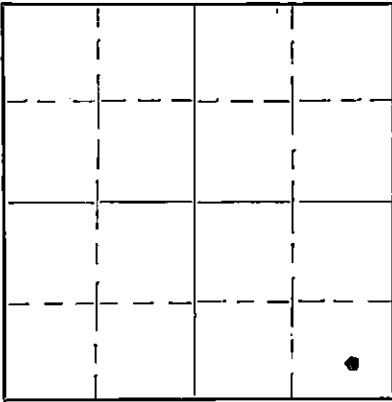

Locate well correctly on above
Section Plat

Russell

County. Sec. 7 Twp. 13 Rge. 14 (E) (W)

Location as "NE $\frac{1}{4}$ NW $\frac{1}{4}$ SW $\frac{1}{4}$ " or footage from lines 330-W 380-N from S.E. corner

Lease Owner Cities Service Oil Company

Lease Name Sutton Well No. 1

Office Address Bartlesville, Oklahoma.

Character of Well (completed as Oil, Gas or Dry Hole) Dry Hole

Date, well completed 2-26-1940 193

Application for plugging filed 3-6-1940 193

Application for plugging approved 3-8-1940 193

Plugging Commenced 3-9-1940 193

Plugging Completed 3-14-1940 193

Reason for abandonment of well or producing formation Dry Hole

If a producing well is abandoned, date of last production 193

Was permission obtained from the Conservation Division or its agents before plugging was commenced? Yes

C.T. Alexander

Name of Conservation Agent who supervised plugging of this well C.T. Alexander
Producing formation Arbuckle Depth to top Bottom Total Depth of Well 3118' Feet

Show depth and thickness of all water, oil and gas formations.


OIL, GAS OR WATER RECORDS

CASING RECORD

Formation	Content	From	To	Size	Put In	Pulled Out
Arbuckle Lime	Dry			10"	356'	None
Kansas City Lime	Water			7"	3094'	2460'

Describe in detail the manner in which the well was plugged, indicating where the mud fluid was placed and the method or methods used in introducing it into the hole. If cement or other plugs were used, state the character of same and depth placed, from feet to feet for each plug set.

Filled with cement from 3118' to 3078', Mud from 3078' to 2840' set wood plug at 2840' dumped 5 sacks cement, Mud to 350' set plug and filled from 350' to 150' with cement Halliburton method, mud to 10' capped with cement, mud and dirt to surface.

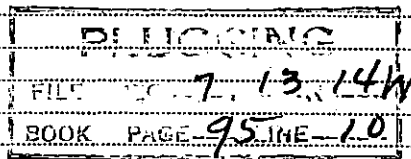

(If additional description is necessary, use BACK of this sheet)

Correspondence regarding this well should be addressed to H.C. Hauber
Address Cities Service Oil Company Great Bend, Kansas

4-3-40

STATE OF Kansas, COUNTY OF Russell

J.A. Cleverley (employee of owner) or (owner or operator) of the above-described well, being first duly sworn on oath, says: That I have knowledge of the facts, statements and matters herein contained and the log of the above-described well as filed and that the same are true and correct. So help me God.

(Signature) [Signature]
Cities Service Oil Co. Russell, Kansas

(Address)

SUBSCRIBED AND SWORN to before me this 30 day of March, 19 40

January 26, 1942

My commission expires

Notary Public.

WELL RECORD

Company Cities Service Oil Co. No. 1 Farm Sutton

Location 330' W, 360' N. of SE Cor. Sec. 7 T. 15 R. 14-W

Elevation 1648 County Russell State Kansas

Drig. Commenced Jan. 31, 1940

Date Completed Feb. 15, 1940 Initial Production Dry Hole

Contractor: Cotal Drilling Company

Total Depth 3118'

CASING RECORD:

10-3/4" 368' con. with 225 ex Oil Max
left in
7" 3094' con. with 100 ex Ideal
cement - Pulled 2460'

FORMATION RECORD:

surface clay & sand	0-40
sand	65
shale & shells	288
iron	316
lime & shale	365
shale & sand	405
red bed & sand	590
red rock	720
hard sand	735
anhydrite	765
shale & shells	1125
salt	1510
shale & lime shells	1400
shale & lime	1795
lime	1855
broken lime	1980
shale	2080
shale & lime	2335
shale	2480
lime & shale	2670
lost circulation 2670	
lime	2842
lime hard	2960
lime soft	2870
lime hard	2872
lime	2992
lime hard	2925
lime soft	2932
lime	2936
lime & chert	2934
lime	3092
cored lime (rec. 10')	3103
cored lime (rec. 4 1/2')	3107
lime & chert	3114
chert	3118 T. D.

Top Lansing	2925
Top Arbuckle	3090
Penetration	28
Total Depth	3118

Top cement in casing 3070.

Perforated Kansas City shows by Lane-
Wells as follows:
20 shots 3074-77 1/2
20 shots 2990-93

Acidized 3000 gallons Feb. 21, 1940.

Perforated by Lane-Wells as follows:
18 shots 2914-17 1/2
19 shots 2961-64 1/2
20 shots 2943-46 1/2

2/3 bailer water with some free oil
per hour.

Acidized 5000 gallons Feb. 26, 1940.

Dry hole.

SLOPE TEST:	250'	00
	500'	00
	750'	10
	1000'	10
	1050'	10
	1500'	10
	1750'	10
	2000'	10
	2250'	00
	2500'	00
	2750'	00
	3000'	00

Rotary 0-3118'.

PLUGGING
FILE SEC 7-13-14W
BOOK PAGE 95-LINE 10

APPT
M. J. ...



CITIES SERVICE OIL COMPANY

PRODUCERS-REFINERS-MARKETERS OF PETROLEUM PRODUCTS

**BARTLESVILLE
OKLAHOMA**

Great Bend, Kansas
April 12, 1940

State Corporation Commission
Conservation Division
800 Bitting Building
Wichita, Kansas

Gentlemen:

Attached herewith is Well Plugging Record of the work done in connection with plugging and abandoning our Sutton well No. 1, Section 7-13-14W, Russell County, Kansas, drilled as a dry hole.

To complete all records, we are also attaching written Well Plugging Application, together with log of the well.

Yours very truly,

CITIES SERVICE OIL COMPANY

R. C. Hauber

EH:
Attach.



PLUGGING
FILE SEC 7-13-14W
BOOK PAGE 45 LINE 10

APR 13 1940
STATE CORP. COMM.
CONSERV. DIV.