


WELL PLUGGING RECORD

Give All Information Completely
Make Required AG's Visit
Mail or Deliver Report to:
Conservation Division
State Corporation Commission
211 No. Broadway
Wichita, Kansas

NORTH

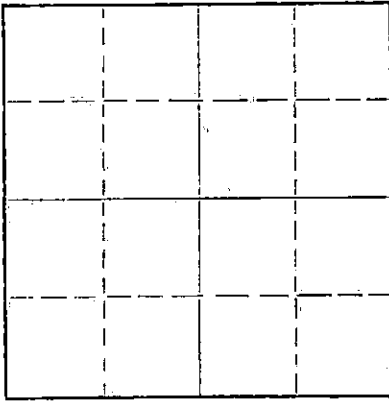

Locate well correctly on above
Section Plat

Russell County. Sec. 6 Twp. 13 Rge. 14 (E) W(W)
Location as "NE/CNW%SW%" or footage from lines: W/2 SW/4 SE/4
Lease Owner McCully, Shaffer & Shaffer
Lease Name McCully Well No. 2
Office Address c/o W. R. Shaffer, Russell, Kansas
Character of Well (completed as Oil, Gas or Dry Hole) Dry hole
Date well completed 2-28 1963
Application for plugging filed 2-28 1963
Application for plugging approved 2-28 1963
Plugging commenced 2-28 1963
Plugging completed 2-28 1963
Reason for abandonment of well or producing formation Dry hole

If a producing well is abandoned, date of last production 19
Was permission obtained from the Conservation Division or its agents before plugging was commenced? Yes

Name of Conservation Agent who supervised plugging of this well Donald Truan
Producing formation _____ Depth to top _____ Bottom _____ Total Depth of Well 3,258 Feet
Show depth and thickness of all water, oil and gas formations.

OIL, GAS OR WATER RECORDS

CASING RECORD

FORMATION	CONTENT	FROM	TO	SIZE	PUT IN	PULLED OUT
				8 5/8"	381'	Cmtd w/225 sax

Describe in detail the manner in which the well was plugged, indicating where the mud fluid was placed and the method or methods used in introducing it into the hole. If cement or other plugs were used, state the character of same and depth placed, from _____ feet to _____ feet for each plug set.

Fill w/ heavy mud to 382'
Set bridge plug @ 382'
Dump 30 sax cement on plug thru 4 1/2" drill pipe
Fill w/ heavy mud to 40'
Set bridge plug @ 40' w/ 1/4 sax hulls on plug
Dump 10 sax cement on plug to cellar

RECEIVED
STATE CORPORATION COMMISSION

MAY 10 1963

CONSERVATION DIVISION
Wichita, Kansas

5-10-63

(If additional description is necessary, use BACK of this sheet)

Name of Plugging Contractor Shields Drilling Co., Inc.
Address Shields Building, Russell, Kansas

STATE OF Kansas, COUNTY OF Russell, ss.
R. L. Shields (Contractor) (employee of owner or owner or operator) of the above-described well, being first duly sworn on oath, says: That I have knowledge of the facts, statements, and matters herein contained and the log of the above-described well as filed and that the same are true and correct. So help me God.

(Signature) R. L. Shields
Shields Building, Russell, Kansas
(Address)

SUBSCRIBED AND SWORN TO before me this 13th day of March, 1963

My commission expires November 9, 1963

Stephen C. Becker
Notary Public.





Shields


WELL LOG

Russell, Kansas

Operator: McCully, Shaffer & Shaffer
 Well: McCully #2
 Commenced: February 21, 1963
 Completed: February 28, 1963
 Contractor: Shields Drilling Co., Inc.

Well Description:

W/2 SW/4 SE/4
 Sec. 6-13S-14W
 Russell County,
 Kansas

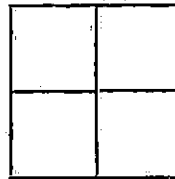

Elevation:

Treatment:

Production:

Tops:

CASING RECORD

Size	Run	Pulled
8 5/8"	381'	Cmtd w/225 sax

..... Figures Indicate Bottom of Formations

Clay, post rock, shale, sand	382'
Shale, sand, redbed	540'
Redbed & shale	790'
Anhydrite	824'
Shale & shells	965'
Shale, salt, shells	1,435'
Lime & shale	1,790'
Lime	1,880'
Shale & lime	2,980'
Lime	3,258' RTD

RECEIVED
 STATE CORPORATION COMMISSION
 MAY 10 1963
 CONSERVATION DIVISION
 Wichita, Kansas

Notes