


STATE OF KANSAS
STATE CORPORATION COMMISSION

WELL PLUGGING RECORD

Give All Information Completely
Make Required Affidavit
Mail or Deliver Report to
Conservation Division
State Corporation Comm.
245 North Water
Wichita, KS 67202

Edwards County, Sec. 8 Twp. 24S Rge. 17W E/W
Location as "NE/CNW 1/4 SW 1/4" or footage from lines
440' FNL, 440' FWL, SW/4
Lease Owner F. G. Holl
Lease Name McIlvain #1 Well No. 1
Office Address 6427 East Kellogg, Wichita, Kansas 67207
Character of Well (Completed as Oil, Gas or Dry Hole)

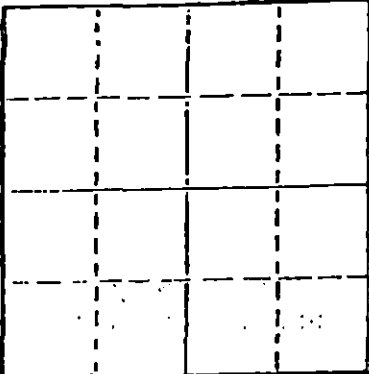

Locate well correctly on above
Section Plat

Dry Hole
Date Well completed November 22, 1977 19
Application for plugging filed November 22, 1977 19
Application for plugging approved November 22, 1977 19
Plugging commenced 11:30 AM November 22, 1977 19
Plugging completed 1:00 PM November 22, 1977 19
Reason for abandonment of well or producing formation
Dry Hole

If a producing well is abandoned, date of last production 19

Was permission obtained from the Conservation Division or
its agents before plugging was commenced? Yes

Name of Conservation Agent who supervised plugging of this well Wm. T. Owen
Producing formation Depth to top Bottom Total Depth of Well 4500'
Show depth and thickness of all water, oil and gas formations.

OIL, GAS OR WATER RECORDS

CASING RECORD

FORMATION	CONTENT	FROM	TO	SIZE	PUT IN	PULLED OUT
				8 5/8"	256'	None

Describe in detail the manner in which the well was plugged, indicating where the mud fluid was placed and the method or methods used in introducing it into the hold. If cement or other plugs were used, state the character of same and depth placed, from feet to feet for each plug set.

Filled hole with heavy mud.
Spotted 40 sacks cement at 500' thru
open end drillpipe; heavy mud to 240',
25 sacks cement; filled hole to 40',
solid bridge, 1/2 sack hulls, 12 sacks cement;
3 sacks in rathole.

RECEIVED
STATE CORPORATION COMMISSION
NOV 29 1977
CONSERVATION DIVISION
Wichita, Kansas

(If additional description is necessary, use BACK of this sheet)

Name of Plugging Contractor Sterling Drilling Company
P. O. Box 129, Sterling, Kansas 67579

STATE OF KANSAS COUNTY OF RICE, ss.
Bernard Laudermilk, (employee of owner) or (owner or operator)
of the above-described well, being first duly sworn on oath, says: That I have knowledge of
the facts, statements, and matters herein contained and the log of the above-described well
as filed and that the same are true and correct. So help me God.

(Signature) Bernard Laudermilk
Bernard Laudermilk, President
P. O. Box 129, Sterling, Kansas 67579
(Address)

SUBSCRIBED AND SWORN TO before me this 23rd day of November, 1977

Shonda K. Baker
Notary Public.

My commission expires



STERLING DRILLING COMPANY
P. O. Box 129
Sterling, Kansas 67579

WELL LOG ----- McILVAIN #1

Located: 440' FNL, 440' FNL, SW/4, Section 6-24S-17N,
Edwards County, Kansas

OWNER: F. G. Holl
ROTARY DRILLING CONTRACTOR: Sterling Drilling Company

COMMENCED: November 12, 1977
COMPLETED: November 22, 1977

TOTAL DEPTH: 4500'

LOG	CASING RECORD
0 - 260 Sand and Shale	Ran 6 joints 8 5/8" OD casing, 259.48'
260 - 1140 Shale - Red Bed	set at 256' K.B. with 225' sacks. 60/40
1140 - 1670 Shale	Peamix, 3% cc. Plug down at 9:45 PM,
1670 - 2235 Lime and Shale	11-12-77, by Howco.
2235 - 2370 Lime	
2370 - 2885 Lime and Shale	
2885 - 3210 Lime	
3210 - 3335 Lime and Shale	
3335 - 4500 Lime	Plugged.

RECEIVED
STATE CORPORATION COMMISSION
NOV 29 1977
CONSERVATION DIVISION
Wichita, Kansas