

STATE OF KANSAS
STATE CORPORATION COMMISSION

WELL PLUGGING RECORD


Give All Information Completely
Make Required Affidavit
Mail or Deliver Report to
Conservation Division
State Corporation Comm.
245 North Water
Wichita, KS 67202

Edwards County. Sec. 8 Twp. 24S Rge. 17W E/W
Location as "NE/CNW $\frac{1}{4}$ SW $\frac{1}{4}$ " or footage from lines
440' FSL & 440' FEL, SW/4

Lease Owner F.G. Holl
Lease Name McIlvain Well No. 2-8

Office Address 6427 E. Kellogg
Character of Well (Completed as Oil, Gas or Dry Hole)
Dry hole

Date Well completed 11-24 19 78
Application for plugging filed 11-24 19 78
Application for plugging approved 11-24 19 78
Plugging commenced 11-24 19 78
Plugging completed 11-24 19 78
Reason for abandonment of well or producing formation

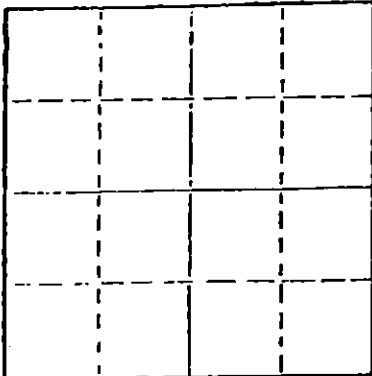

Locate well correctly on above
Section Plat

If a producing well is abandoned, date of last production
19

Was permission obtained from the Conservation Division or
its agents before plugging was commenced? yes

Name of Conservation Agent who supervised plugging of this well Bill Owen
Producing formation Depth to top Bottom Total Depth of Well 4470
Show depth and thickness of all water, oil and gas formations.

OIL, GAS OR WATER RECORDS

CASING RECORD

FORMATION	CONTENT	FROM	TO	SIZE	PUT IN	PULLED OUT
Surface	8 5/8"	0	254'	8 5/8"	254	0

Describe in detail the manner in which the well was plugged, indicating where the mud fluid
was placed and the method or methods used in introducing it into the hold. If cement or other
plugs were used, state the character of same and depth placed, from feet to
feet for each plug set.

Rotary Mud to 540'
Plug & 50 Sx @ 540'
Plug & 40 Sx @ 260'
Solid Bridge Plug & 12 Sx @ 40'
3 Sx in rathole
2 Sx in mousehole

RECEIVED
STATE CORPORATION COMMISSION
FEB 22 1979
CONSERVA
Wichita, Kansas

2-22-79

(If additional description is necessary, use BACK of this sheet)

Name of Plugging Contractor Halliburton Pratt, Kansas

STATE OF Kansas COUNTY OF Sedgwick, ss.
(employee of owner) or (owner or operator)

of the above-described well, being first duly sworn on oath, says: That I have knowledge of
the facts, statements, and matters herein contained and the log of the above-described well
as filed and that the same are true and correct. So help me God.

(Signature) [Signature]
1104 Douglas Bldg. Wichita, Ks.
(Address)

SUBSCRIBED AND SWORN TO before me this 30th day of November, 1978

Mari Jane Nungesser
Notary Public.

My commission expires May 18, 1978




KANSAS DRILLERS LOG

API No. 15 — 047 — 20451-0000
County Number

S. 8 T. 24 R. 17 ^K/_W
 Loc. 440 FSL 440 FEL SW/4

County Edwards

640 Acres
N

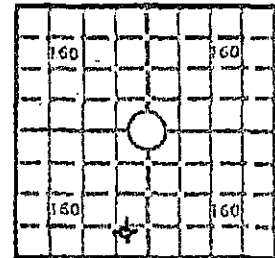

Locate well correctly

Elev.: Gr. 2115

DF 2126 KB 2128

Operator F. G. Holl
 Address 6427 E. Kellogg, Wichita, Kansas 67207
 Well No. 2-8 Lease Name McIlvain
 Footage Location
440 feet from (N) (S) line 440 feet from (E) (W) line
 Principal Contractor Brandt Drilling Company, Inc Geologist Jerry Monk
 Spud Date November 14, 1978 Total Depth 4470 P.B.T.D.
 Date Completed November 24, 1978 Oil Purchaser

CASING RECORD

Report of all strings set — surface, intermediate, production, etc.

Purpose of string	Size hole drilled	Size casing set (in O.D.)	Weight lbs/ft.	Setting depth	Type cement	Sacks	Type and percent additives
Surface	12 1/4"	8 5/8	24#	254 KB	Pos Mix	250	

LINER RECORD

PERFORATION RECORD

Top, ft.	Bottom, ft.	Sacks cement	Shots per ft.	Size & type	Depth interval

TUBING RECORD

Size	Setting depth	Packer set at

RECEIVED
STATE CORPORATION COMMISSION

ACID, FRACTURE, SHOT, CEMENT SQUEEZE RECORD

FEB 22 1979
Depth interval treated

Amount and kind of material used

CONSERVATION DIVISION
Wichita, Kansas

INITIAL PRODUCTION

Date of first production _____ Producing method (flowing, pumping, gas lift, etc.) _____

RATE OF PRODUCTION PER 24 HOURS	Oil	Gas	Water	Gas-oil ratio
	bbis.	MCF	bbis.	CFPB

Disposition of gas (vented, used on lease or sold) _____ Producing interval (s) _____

INSTRUCTIONS: As provided in KCC Rule 82-2-125, within 90 days after completion of a well, one completed copy of this Drillers Log shall be transmitted to the State Geological Survey of Kansas, 4150 Monroe Street, Wichita, Kansas 67209. Copies of this form are available from the Conservation Division, State Corporation Commission, 3830 So. Meridian (P.O. Box 17027), Wichita, Kansas 66217. Phone AC 316-522-2206. If confidential custody is desired, please note Rule 82-2-125. Drillers Logs will be on open file in the Oil and Gas Division, State Geological Survey, of Kansas, Lawrence, Kansas 66044.

Operator F. G. Holl

Well No. 2-8 Lease Name McIlvain Dry Hole

S 8 T 24 R 17 W

WELL LOG

Show all important zones of porosity and contents thereof; cored intervals, and all drill-stem tests, including depth interval tested, cushion used, time tool open, flowing and shut-in pressures, and recoveries.

SHOW GEOLOGICAL MARKERS, LOGS RUN, OR OTHER DESCRIPTIVE INFORMATION.

FORMATION DESCRIPTION, CONTENTS, ETC.	TOP	BOTTOM	NAME	DEPTH
DST # 1 4345-4378			Heebner	3756
			Toronto	3774
			Brown Line	3878
			Lansing	3888
			Base KC	4190
30-30-60-30"			Cherokee Sd	4354
Fair Blow			Mississippian	4370
			Kinderhook	4416
90 feet of mud with oil spots			Kinderhook Sd.	4426
60 feet of Muddy water			Viola	4454
slightly oil stained.			TD Log	4466
IFP 81/81				
FEP 132/142				
SIP 667/649				
IHP 2147				
FHP 2141				
Laterolog - Gamma Ray - Neutron				
Compensated Densilog - Caliper				

USE ADDITIONAL SHEETS, IF NECESSARY, TO COMPLETE WELL RECORD.

Date Received

Elwyn H. Nagel
Signature

Elwyn H. Nagel, Geologist
Title

February 20, 1979
Date