


WELL PLUGGING RECORD

Give All Information Completely  
Make Required Affidavit  
Mail or Deliver Report to:  
Conservation Division  
State Corporation Commission  
212 North Market, Insurance Bldg.  
Wichita, Kansas

Stafford County. Sec. 12 Twp. 24S Rge. 13 ~~13~~ (W)

Location as "NE/CNW/SW" or footage from lines NW/4 NE/4 SW/4  
Lease Owner Barnett Oil Company  
Lease Name Garner Well No. 1  
Office Address 411 First Nat'l Bank Bldg., Wichita, Kansas  
Character of Well (completed as Oil, Gas or Dry Hole) Dry Hole  
Date well completed August 2, 1963  
Application for plugging filed August 9, 1963  
Application for plugging approved (verbal) August 2, 1963  
Plugging commenced August 2, 1963  
Plugging completed August 2, 1963  
Reason for abandonment of well or producing formation Dry Hole

NORTH

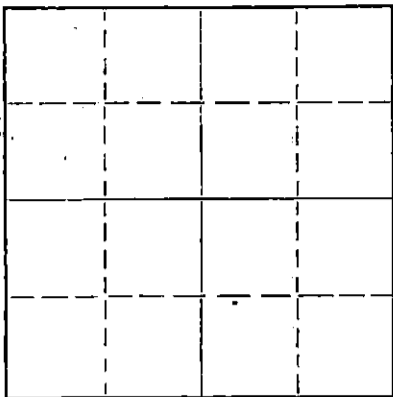

Locate well correctly on above  
Section Plat

If a producing well is abandoned, date of last production \_\_\_\_\_ 19\_\_\_\_  
Was permission obtained from the Conservation Division or its agents before plugging was commenced? Yes

Name of Conservation Agent who supervised plugging of this well O. D. Bryan  
Producing formation None Depth to top \_\_\_\_\_ Bottom \_\_\_\_\_ Total Depth of Well 3896 Feet  
Show depth and thickness of all water, oil and gas formations.

OIL, GAS OR WATER RECORDS

CASING RECORD

FORMATION	CONTENT	FROM	TO	SIZE	PUT IN	PULLED OUT
				8 5/8	260'	None

Describe in detail the manner in which the well was plugged, indicating where the mud fluid was placed and the method or methods used in introducing it into the hole. If cement or other plugs were used, state the character of same and depth placed, from \_\_\_\_\_ feet to \_\_\_\_\_ feet for each plug set.

Filled hole to 240' with mud; plugged with 1/4 sack hulls and 20 sacks cement. Filled to 40' with mud; plugged with 1/4 sack hulls and 10 sacks cement to surface.

Plugged rat hole with 3 sacks cement.

(Well Log attached)

RECEIVED  
STATE CORPORATION COMMISSION

AUG 12 1963

8-12-63

CONSERVATION DIVISION  
Wichita, Kansas

(If additional description is necessary, use BACK of this sheet)  
Name of Plugging Contractor Chemical & Technical Services, Inc.  
Address Box D, Hill City, Kansas

STATE OF Kansas, COUNTY OF Sedgwick, ss.  
J. G. Gould, a partner of Barnett Oil Co. (employee of owner or contractor or operator) of the above-described well, being first duly sworn on oath, says: That I have knowledge of the facts, statements, and matters herein contained and the log of the above-described well as filed and that the same are true and correct. So help me God.

(Signature) J. G. Gould

411 First Nat'l Bank Bldg., Wichita 2, Kansas  
(Address)

SUBSCRIBED AND SWORN TO before me this 9th day of August, 1963

My commission expires February 27, 1964.

Mildred F. Willis  
Notary Public.



CONTRACTOR'S WELL LOG

CONTRACTOR:	CHEMICAL & TECHNICAL SERVICES, INC.
OWNER:	BARNETT OIL COMPANY
WELL:	GARNER #1
LOCATION:	NW NE NW SEC. 12-24S-13W STAFFORD CO., KANSAS
COMMENCED:	7/25/63
COMPLETED:	8/2/63

0	140	CLAY & SAND	ELEVATION:	GROUND LEVEL	1895'
140	250	SAND, CLAY & SHALE		DERRICK FLOOR	1900'
250	475	SHALE		KELLY BUSHING	1902'
475	750	SHALE, RED BED & SAND			
750	771	ANHYDRITE			
771	1050	RED BED & SHALE			
1050	1592	SHALE & SHELLS			
1592	1604	ANHYDRITE			
1604	1760	SHALE & SHELLS			
1760	1940	LIME			
1940	3520	LIME & SHALE			
3520	3605	LIME			
3650	3720	LIME & SHALE			
3720	3765	LIME			
3765	3850	LIME & SHALE			
3850	3896	LIME			
3896		ROTARY TOTAL DEPTH			

RECEIVED  
STATE CORPORATION COMMISSION

AUG 12 1963

CONSERVATION DIVISION  
Wichita, Kansas

SET 8-5/8" CASING @ 260 FT. WITH 250 SACKS CEMENT

DRY & ABANDONED; PLUGGED WITH 20 SACKS CEMENT @ 250', 10 SACKS CEMENT @ 40' TO SURFACE

WE HEREBY CERTIFY THIS TO BE A CORRECT AND ACCURATE LOG OF THE ABOVE DESCRIBED WELL, AS SHOWN ON THE DAILY DRILLING REPORTS.

CHEMICAL & TECHNICAL SERVICES, INC.

BY: *D. J. McCarthy*  
ASST. TREASURER

SUBSCRIBED AND SWORN TO BEFORE THIS 8th DAY OF AUGUST, 1963.

My Commission Expires January 23, 1964

*Conrad D. Sessler*  
NOTARY PUBLIC